MARK UP

30/09/2026

FINISHES
LAM01 - LAMINEX ELEGANT OAK
LAM02 - LAMINEX ARIES. COLOUR TBC
ST01 - BRECCIATE PRIMAVERA MARBLE
ST02 - YDL MAHAL IVORY
MEL01 - WHITE MELAMINE INTERNAL CARCASS

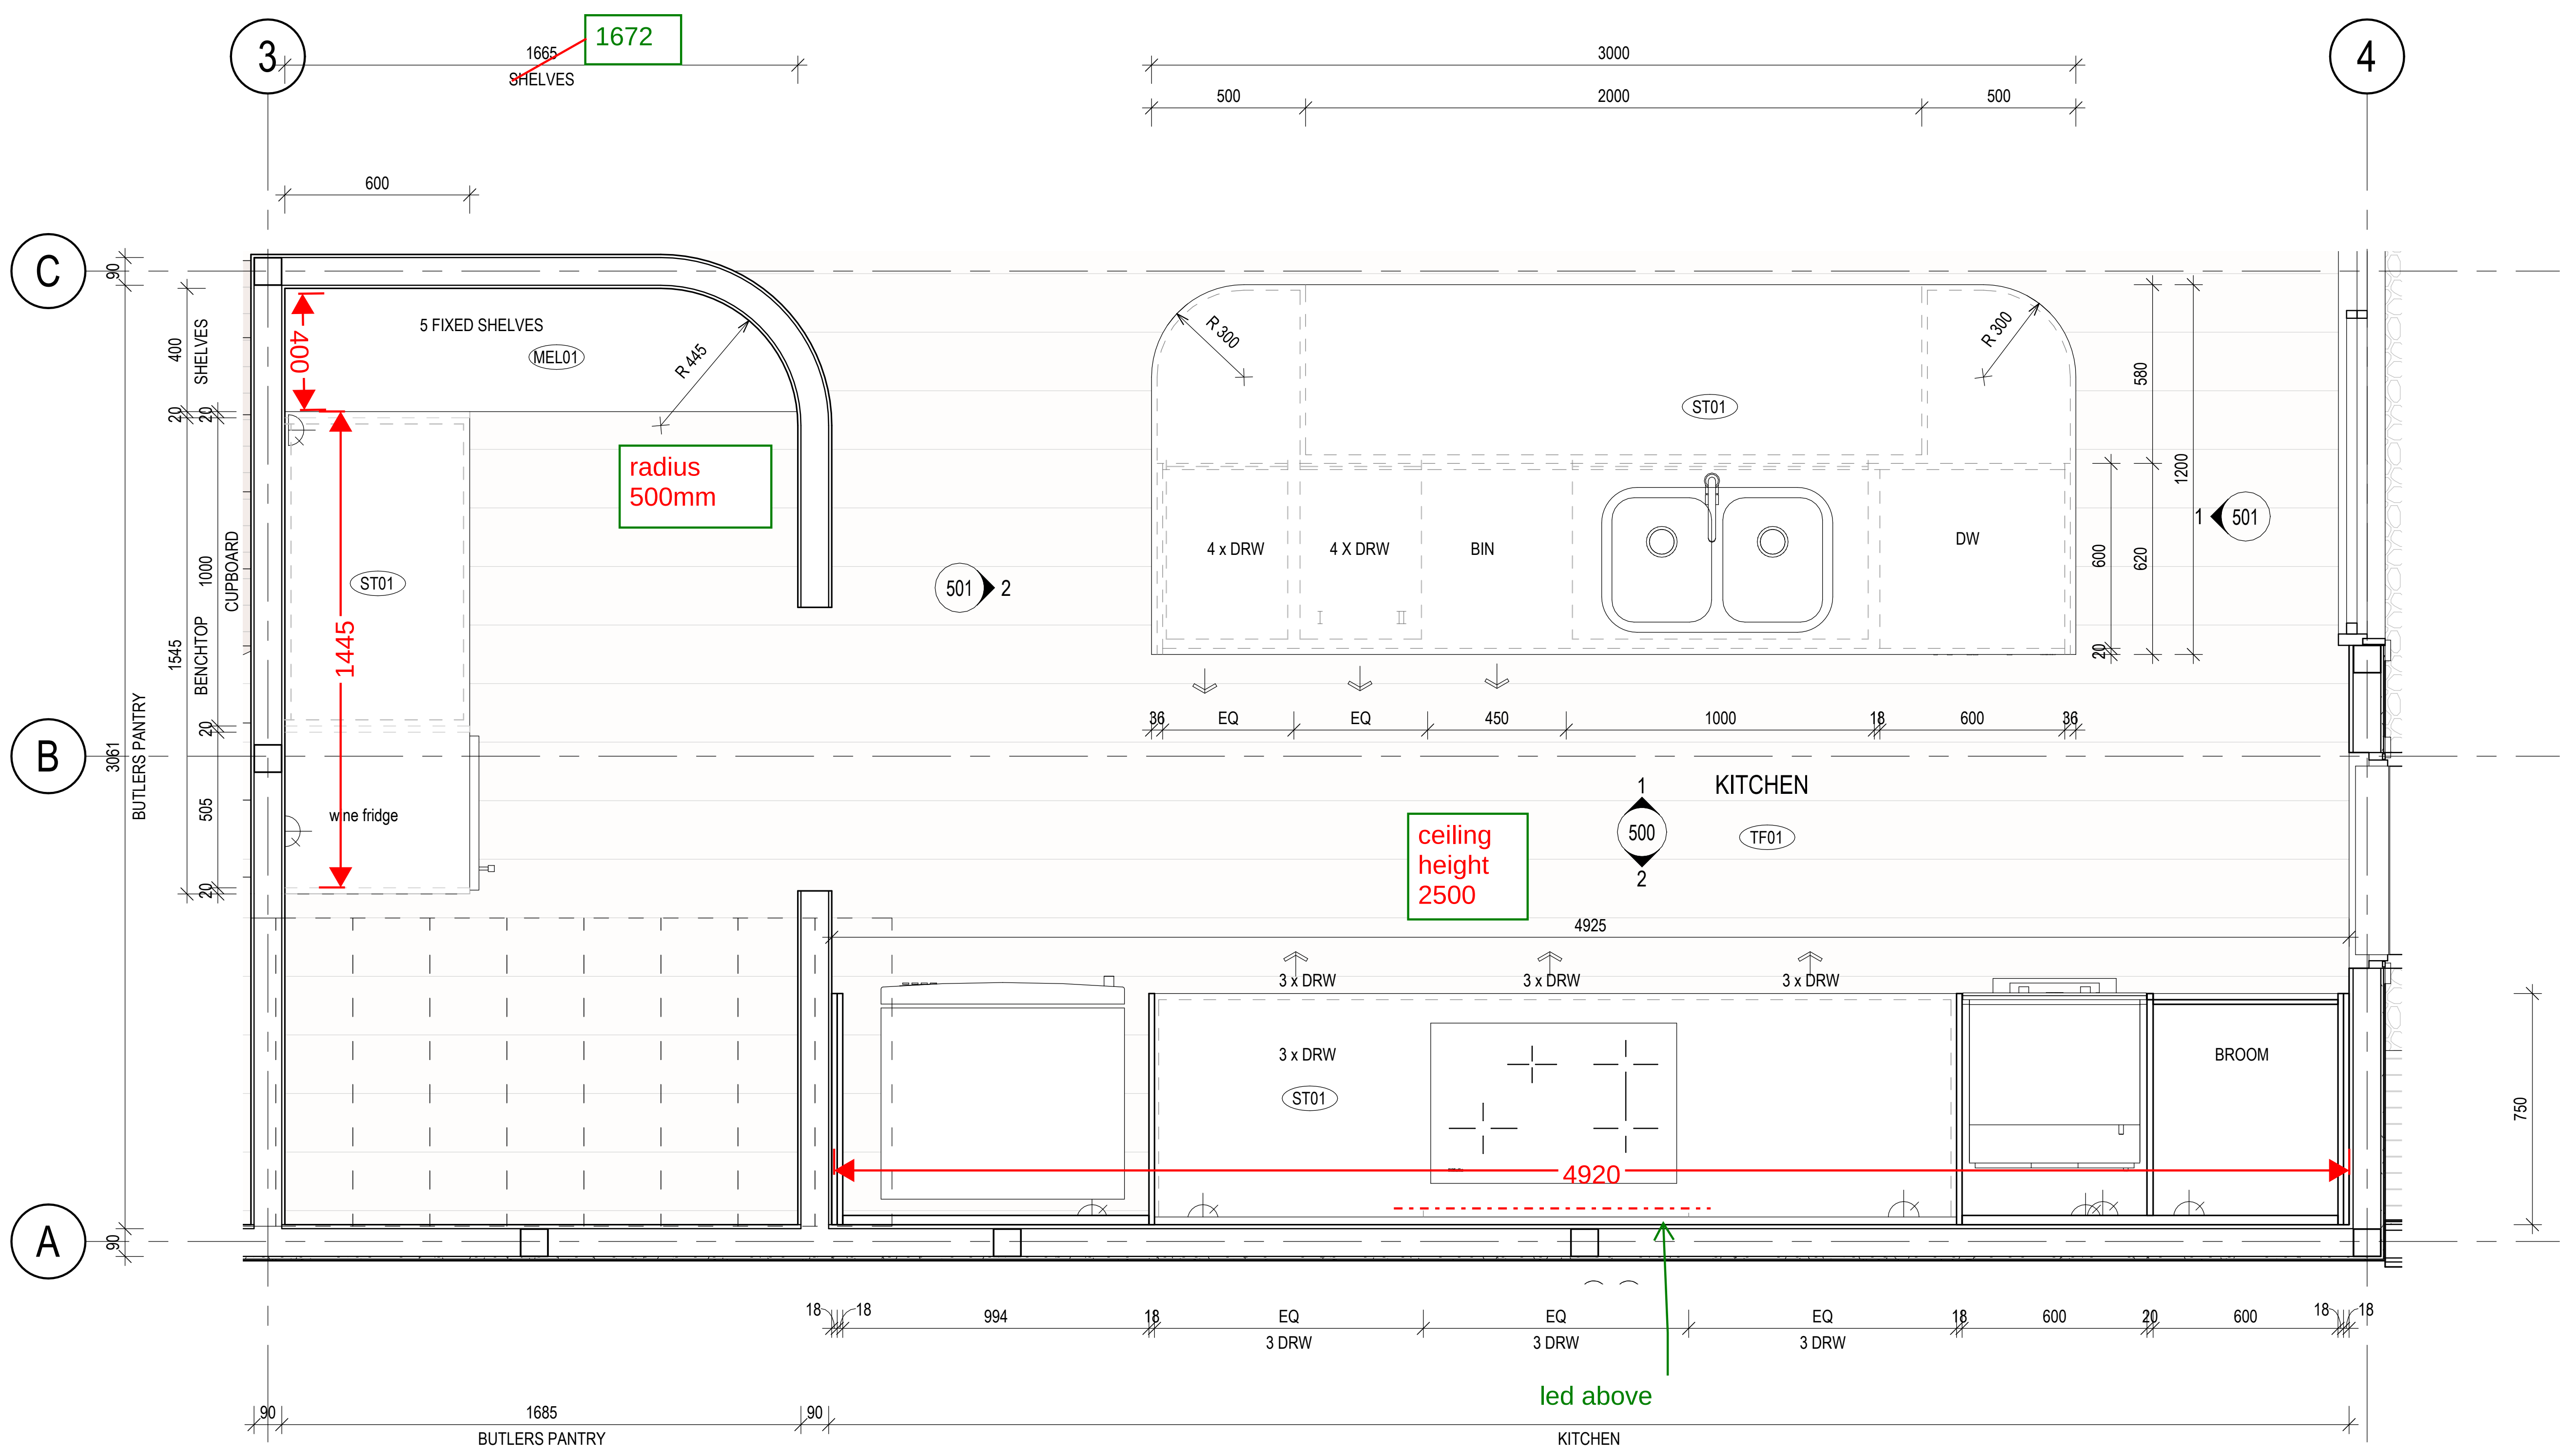

3 / 203 KITCHEN LAYOUT - PLAN
1 : 20

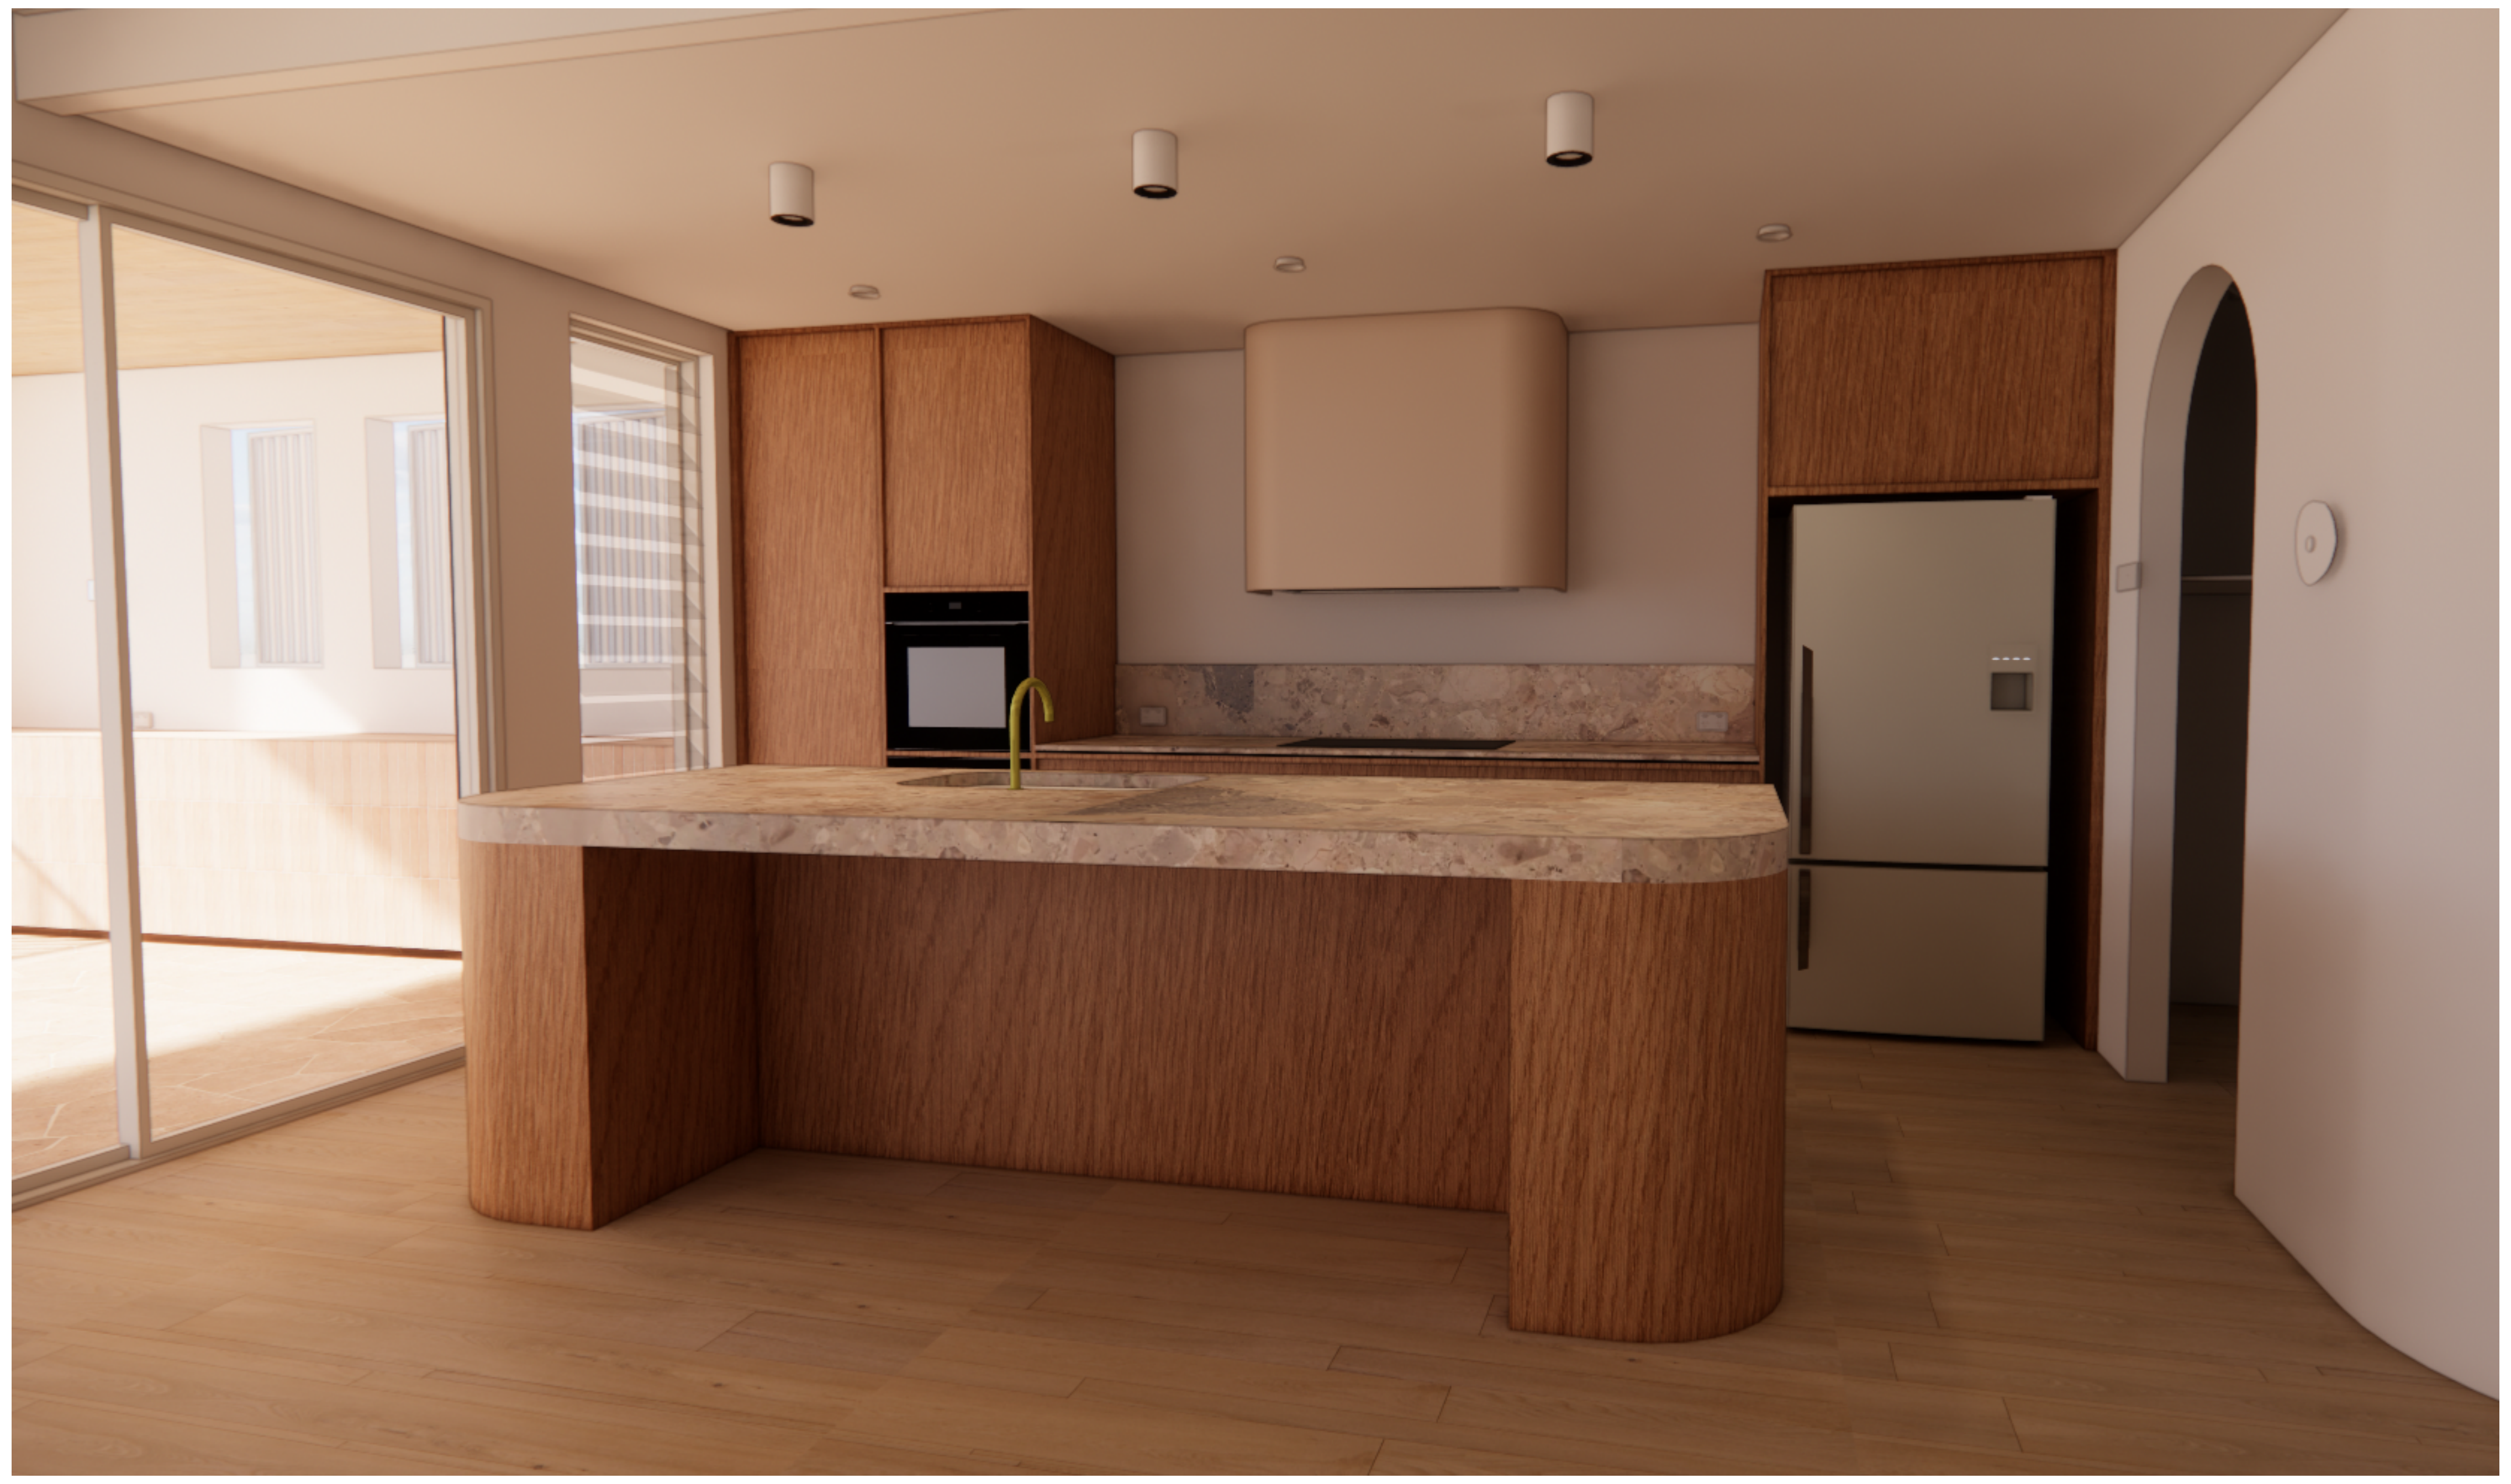

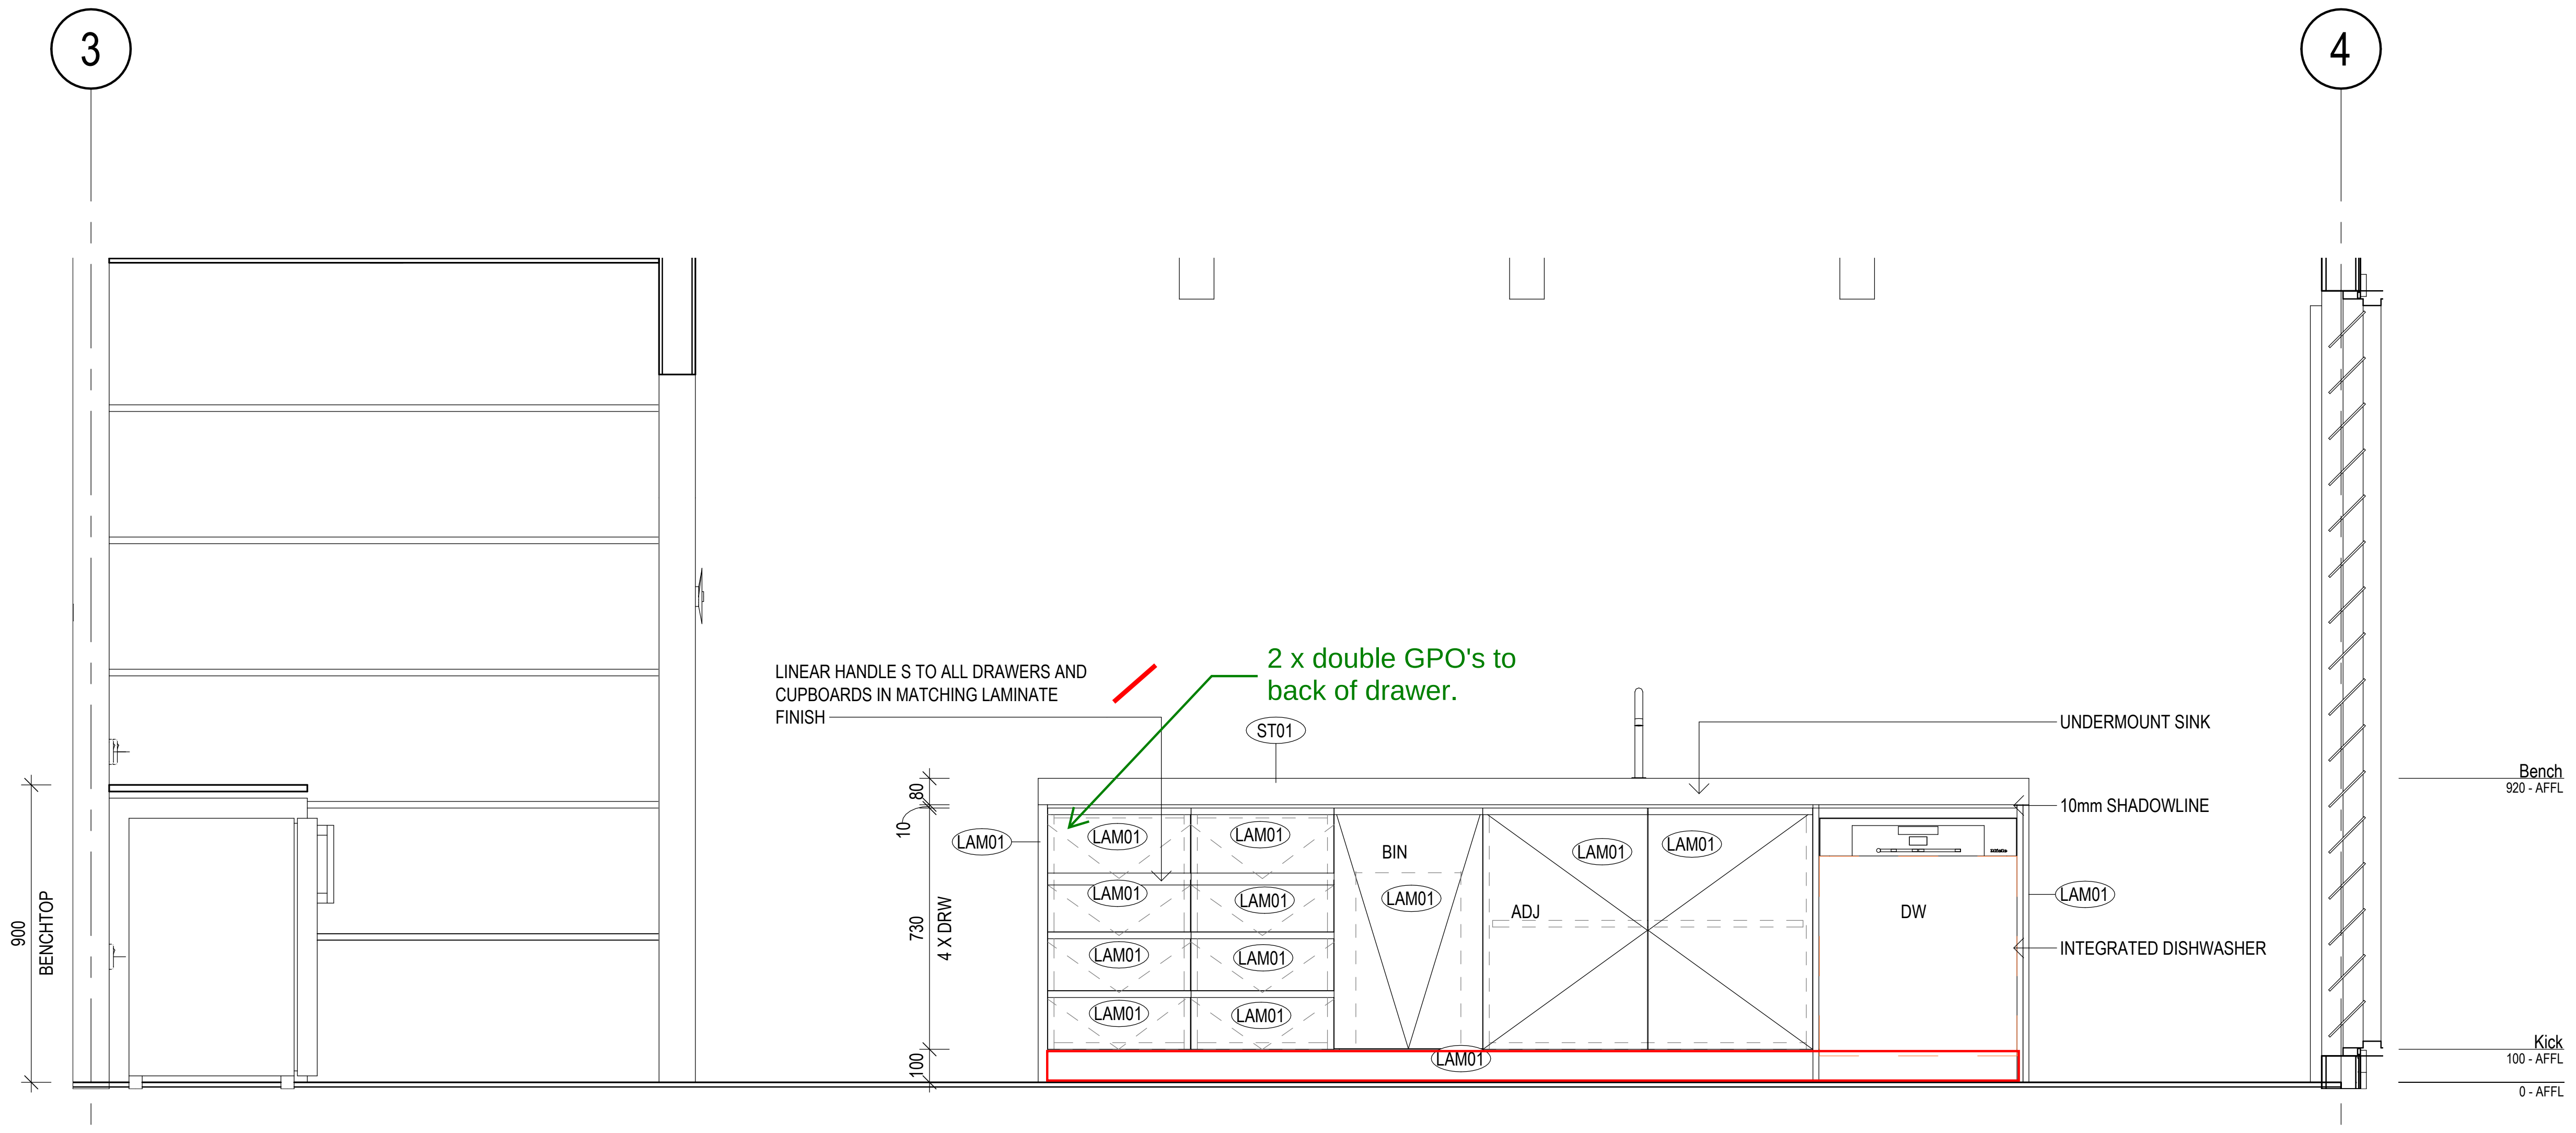

1 / 106 KITCHEN - ELEVATION A
1 : 20

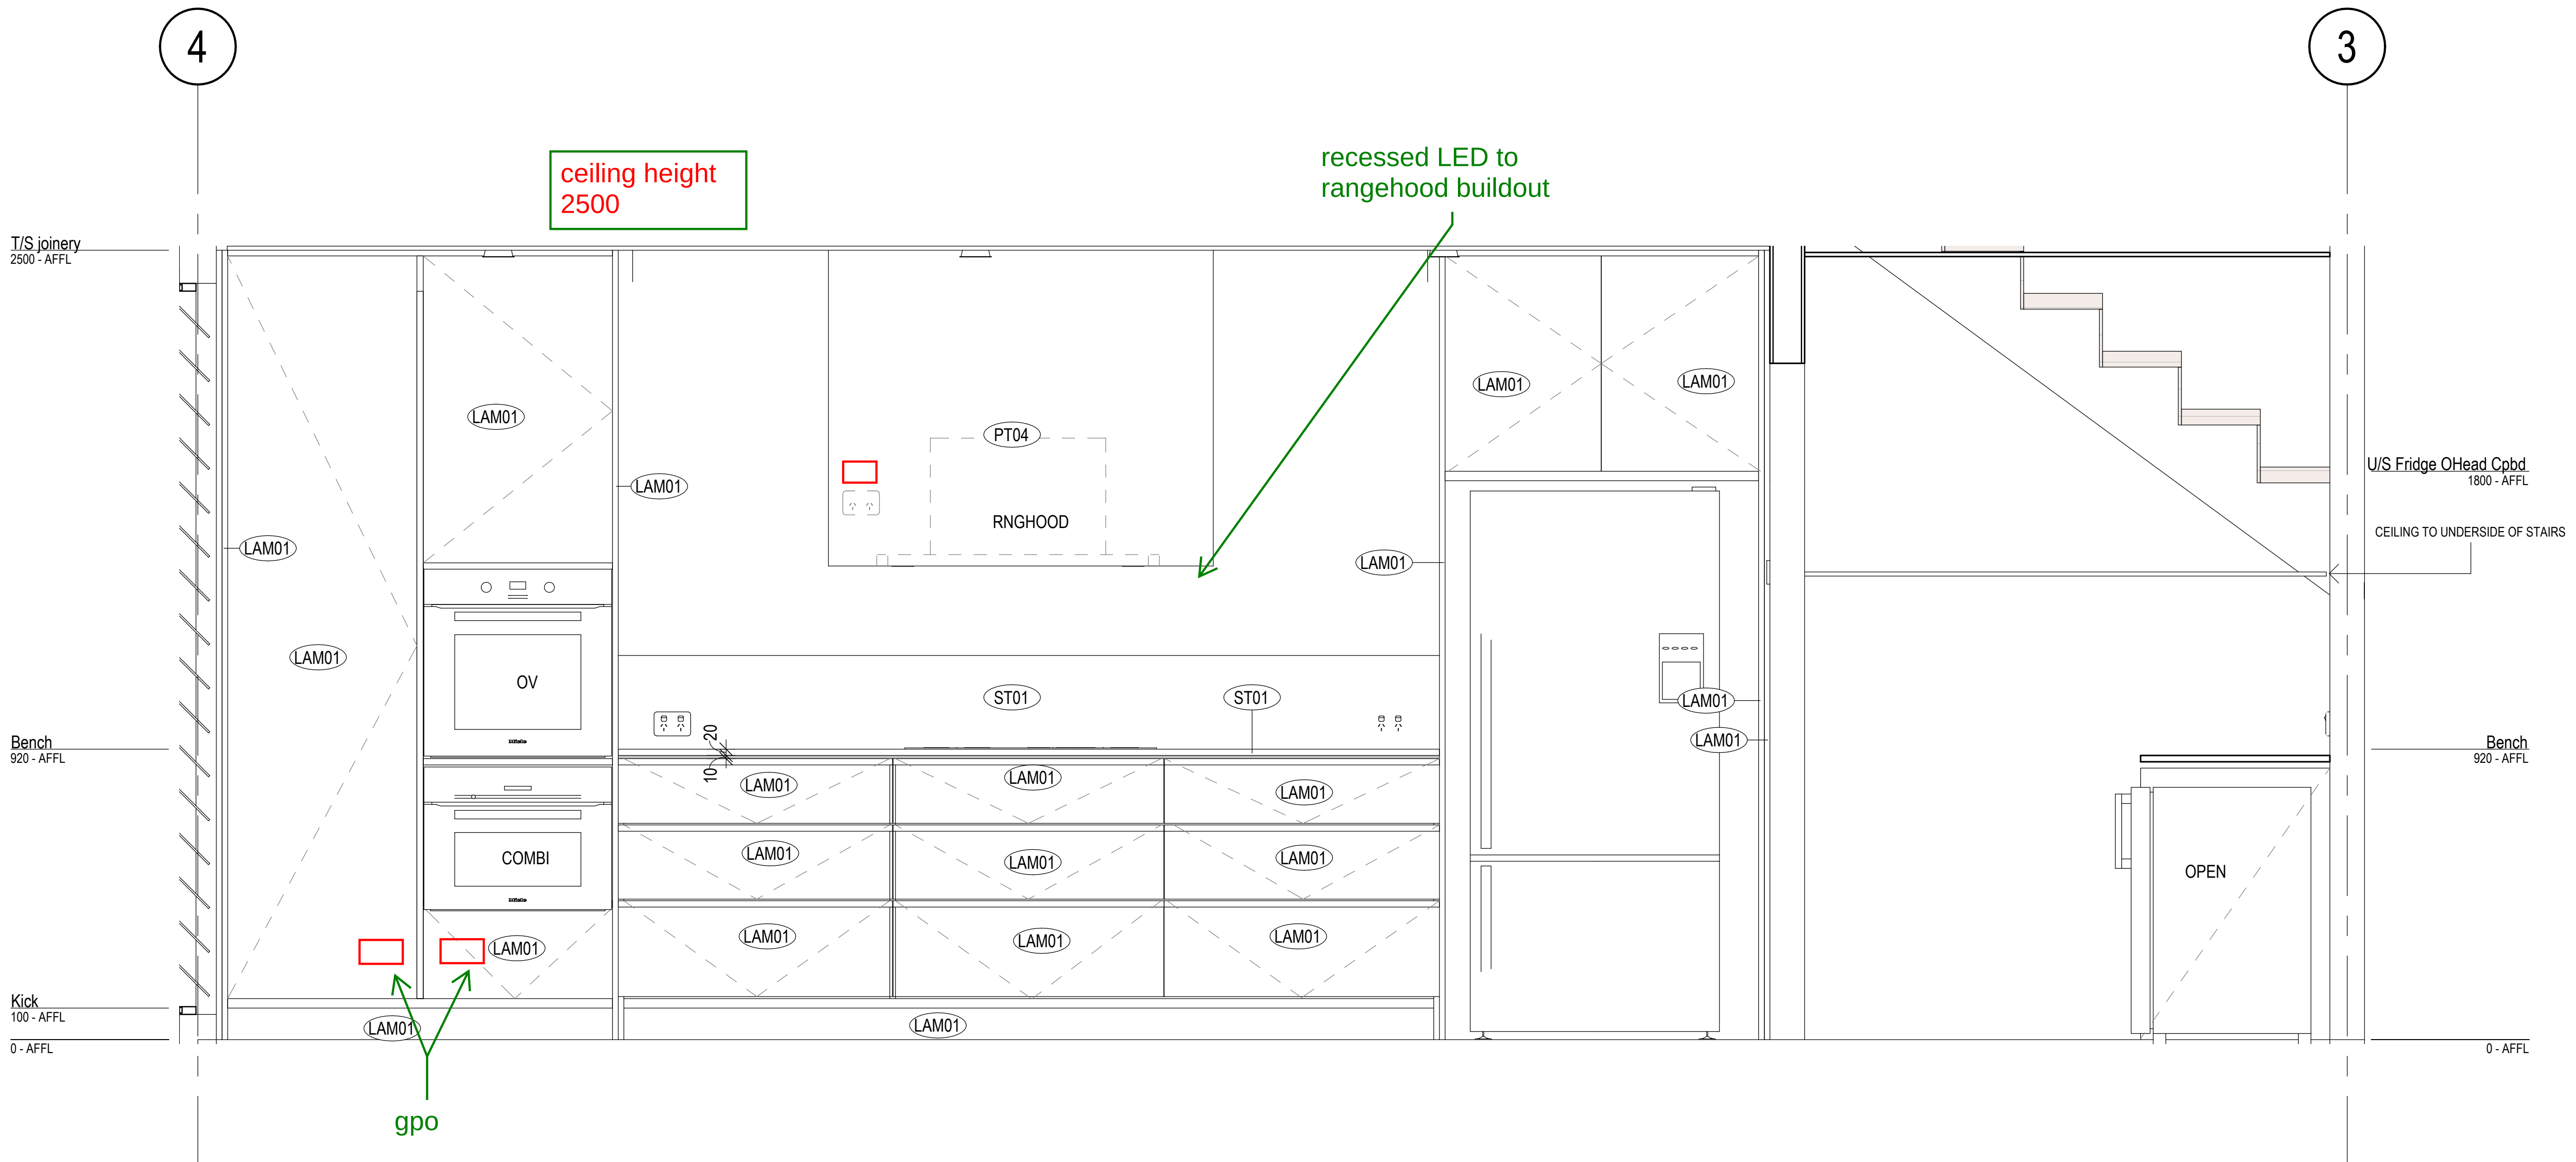

2 / 106 KITCHEN - ELEVATION B
1 : 20

16/08/2026 8:17:24 PM C:\Users\KatherineB\OneDrive - nettletontribe\38 Howard\Revit\Concstruction\38 HOWARD_PROPOSED_ARCH (1).rvt

Client

Client Logo

Issue	Description	Date
B	JOINERY ISSUE 1	16-08-2026
A	ISSUE FOR CONSTRUCTION	26-05-2026

Builder and/or subcontractors shall verify all project dimensions before commencing on-site work or off-site fabrication. Figured dimensions shall take precedence over scaled dimensions. This drawing is copyright and cannot be reproduced in whole or in part or by any medium without the written permission of Katherine Blackham.

Builder

Builders Logo

Project Name
38 Howard Street
Project Address
38 Howard Street, Grange QLD

Key Plan
0 2000 5000

Drawing Title:
KITCHEN - PLAN & ELEVATIONS

Checker: **KB**
Sheet Size: **A1**
Scale: **1:20**
Drawing Number: **2025-01_500**
Issue: **B**

30/09/2026

MARK UP

FINISHES

LAM01 - LAMINEX ELEGANT OAK
LAM02 - LAMINEX ARIES. COLOUR TBC
ST01 - BRECCIATE PRIMAVERA MARBLE
ST02 - YDL MAHAL IVORY
MEL01 - WHITE MELAMINE INTERNAL CARCASS

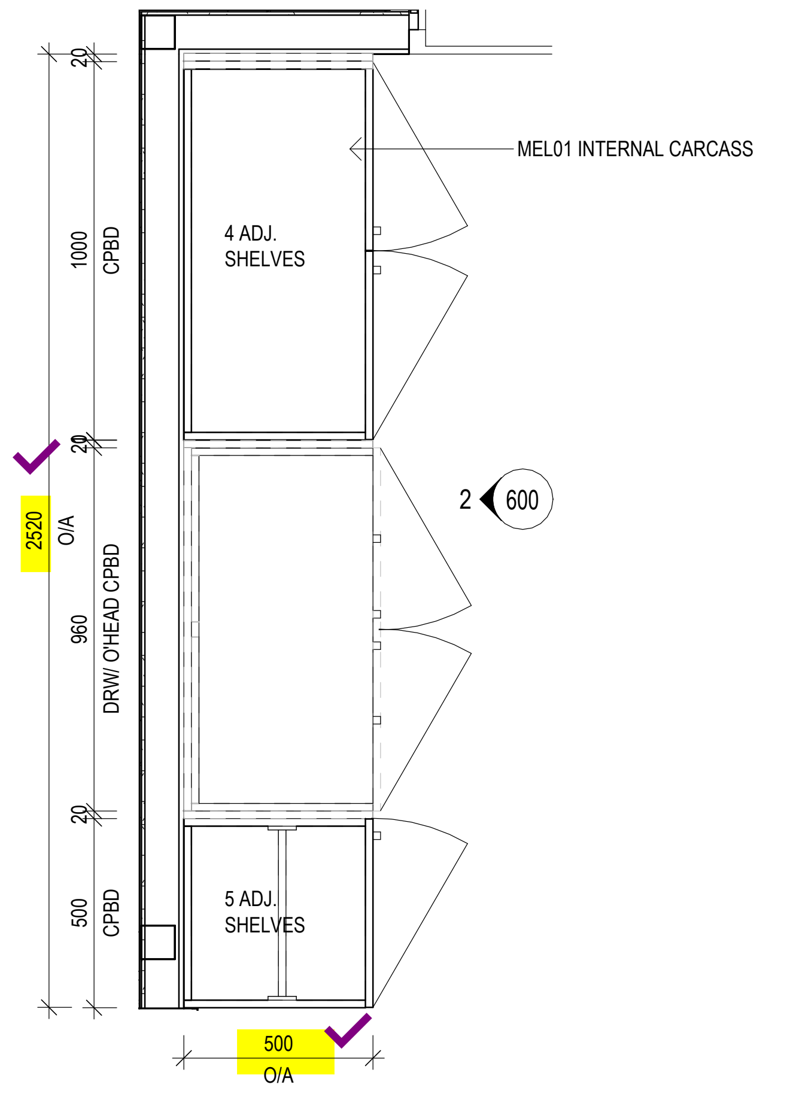

1 / 203 J01 ENTRY JOINERY
1 : 20

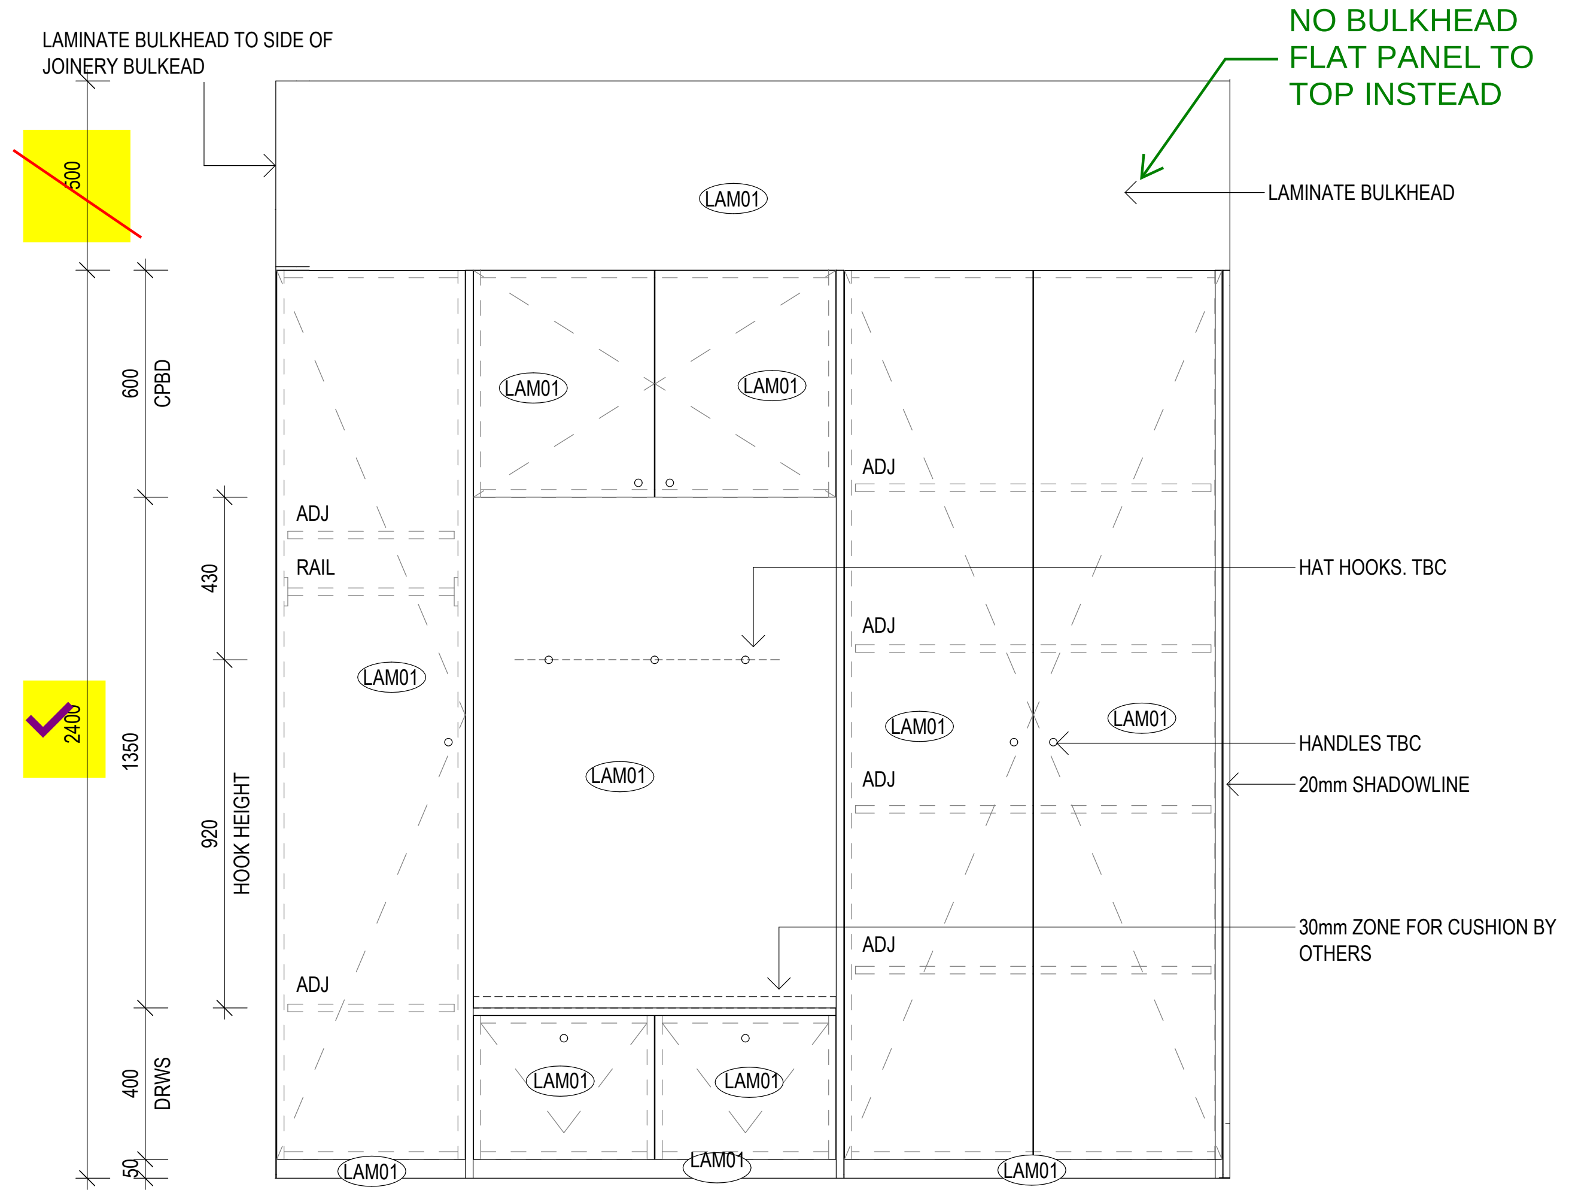

NO BULKHEAD FLAT PANEL TO TOP INSTEAD

2 / 106 J01 ENTRY JOINERY - ELEVATION
1 : 20

NOTE: PROPRIETARY HANDLES TBC

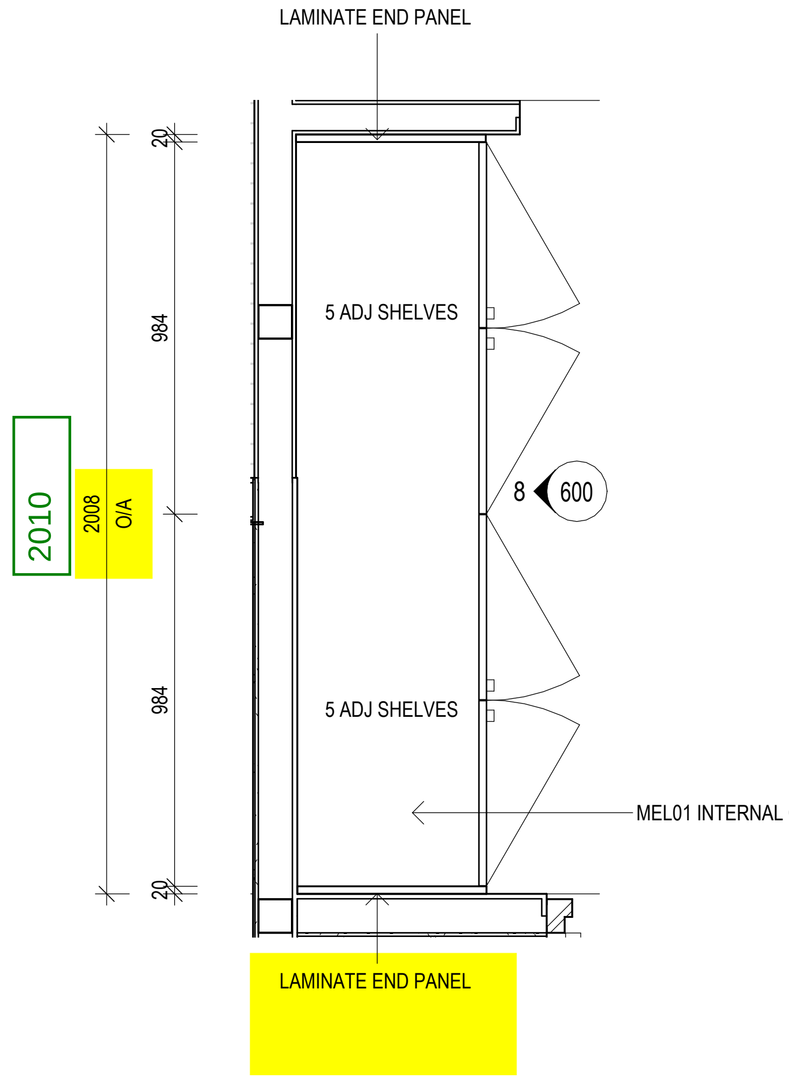

600 OA CUPBOARD DEPTH. END PANEL CAN BE SHADOWLINE TO ALLOW DOORS TO OPEN

7 / 203 J02 - LAUNDRY CPBD
1 : 20

2570 OA.
2400 KICK & CPBD WITH REMAINDER AS BULKHEAD

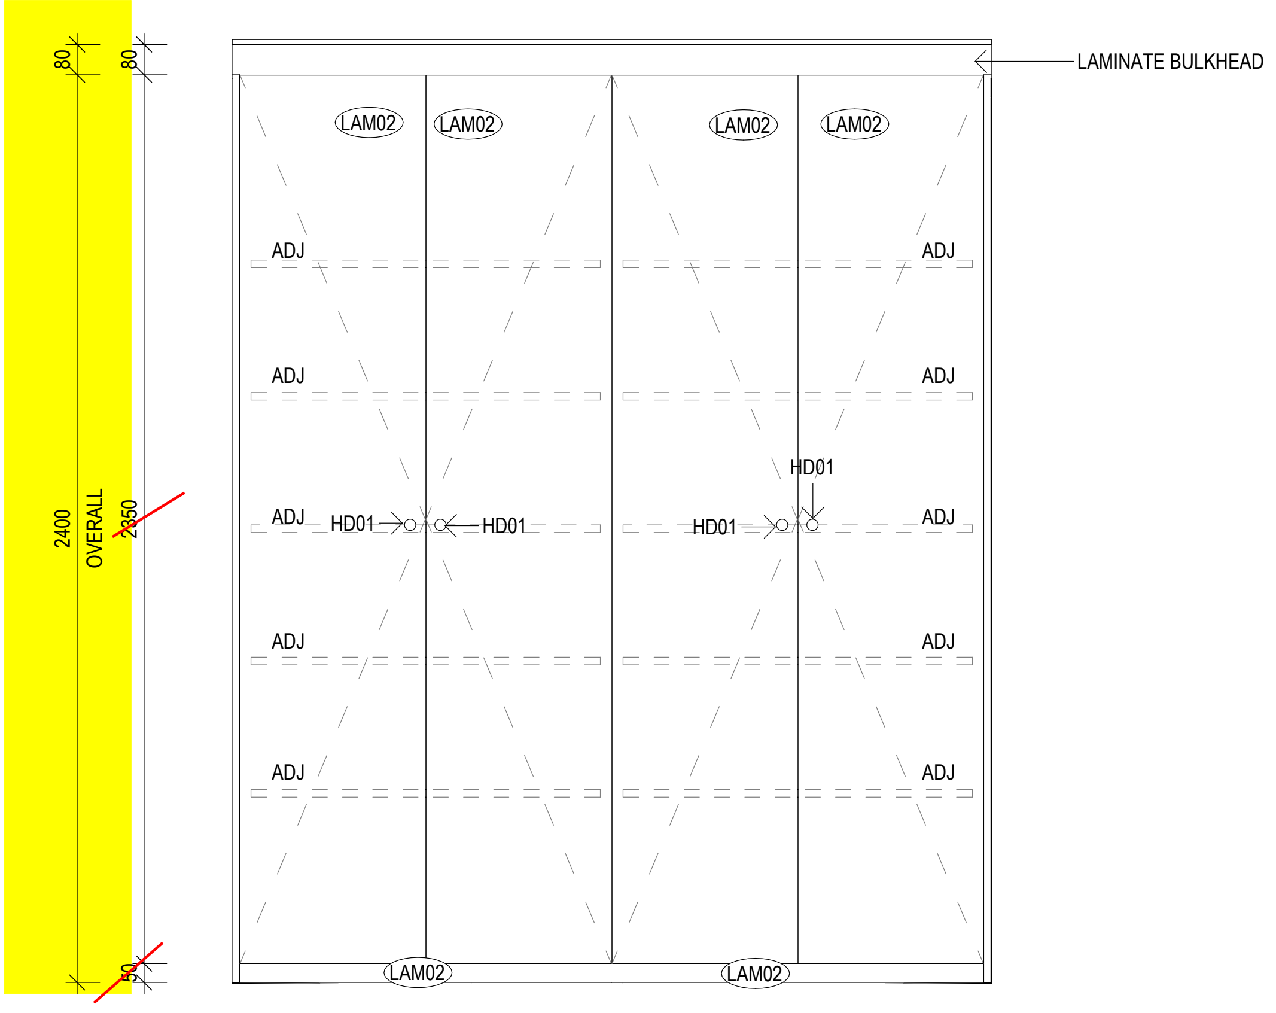

8 / 106 J02 - LAUNDRY CPBD - ELEVATION
1 : 20

NOTE: PROPRIETARY HANDLES TBC

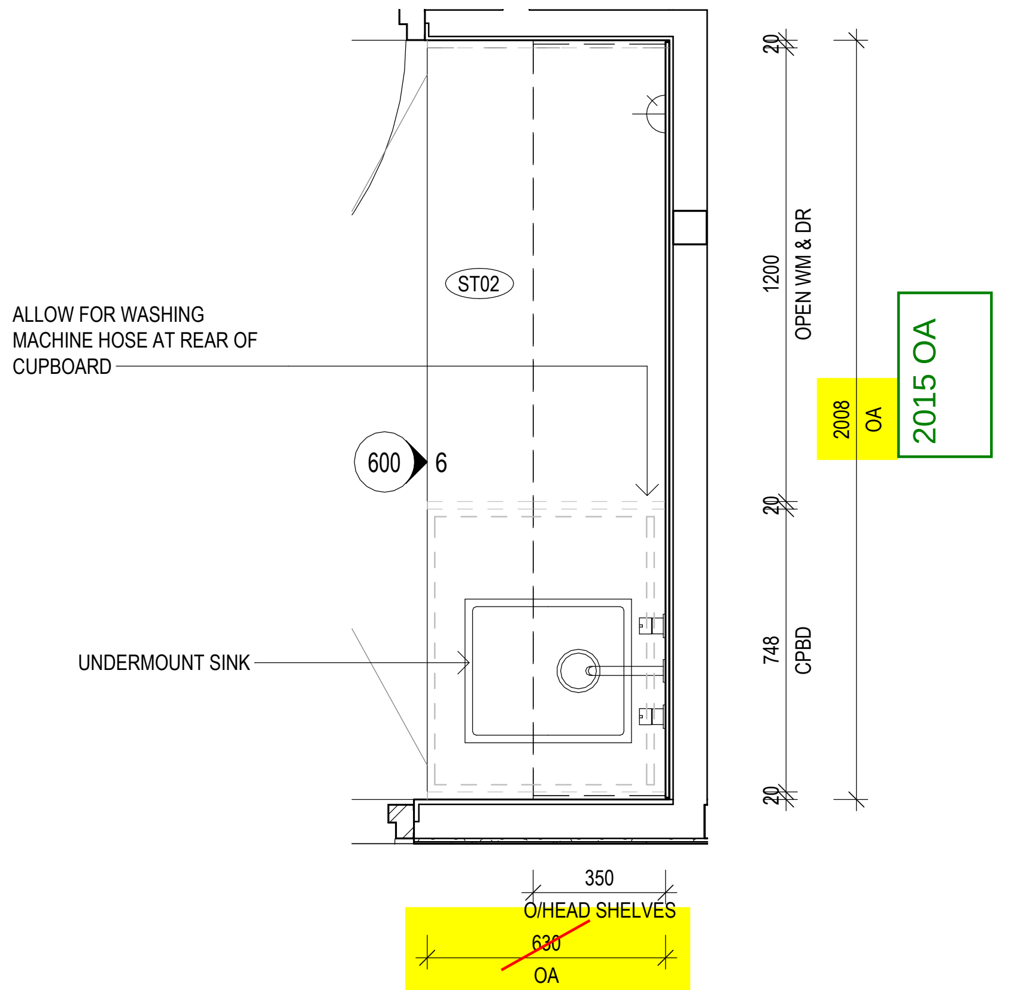

600 DEPTH

5 / 203 J03 - LAUNDRY JOINERY
1 : 20

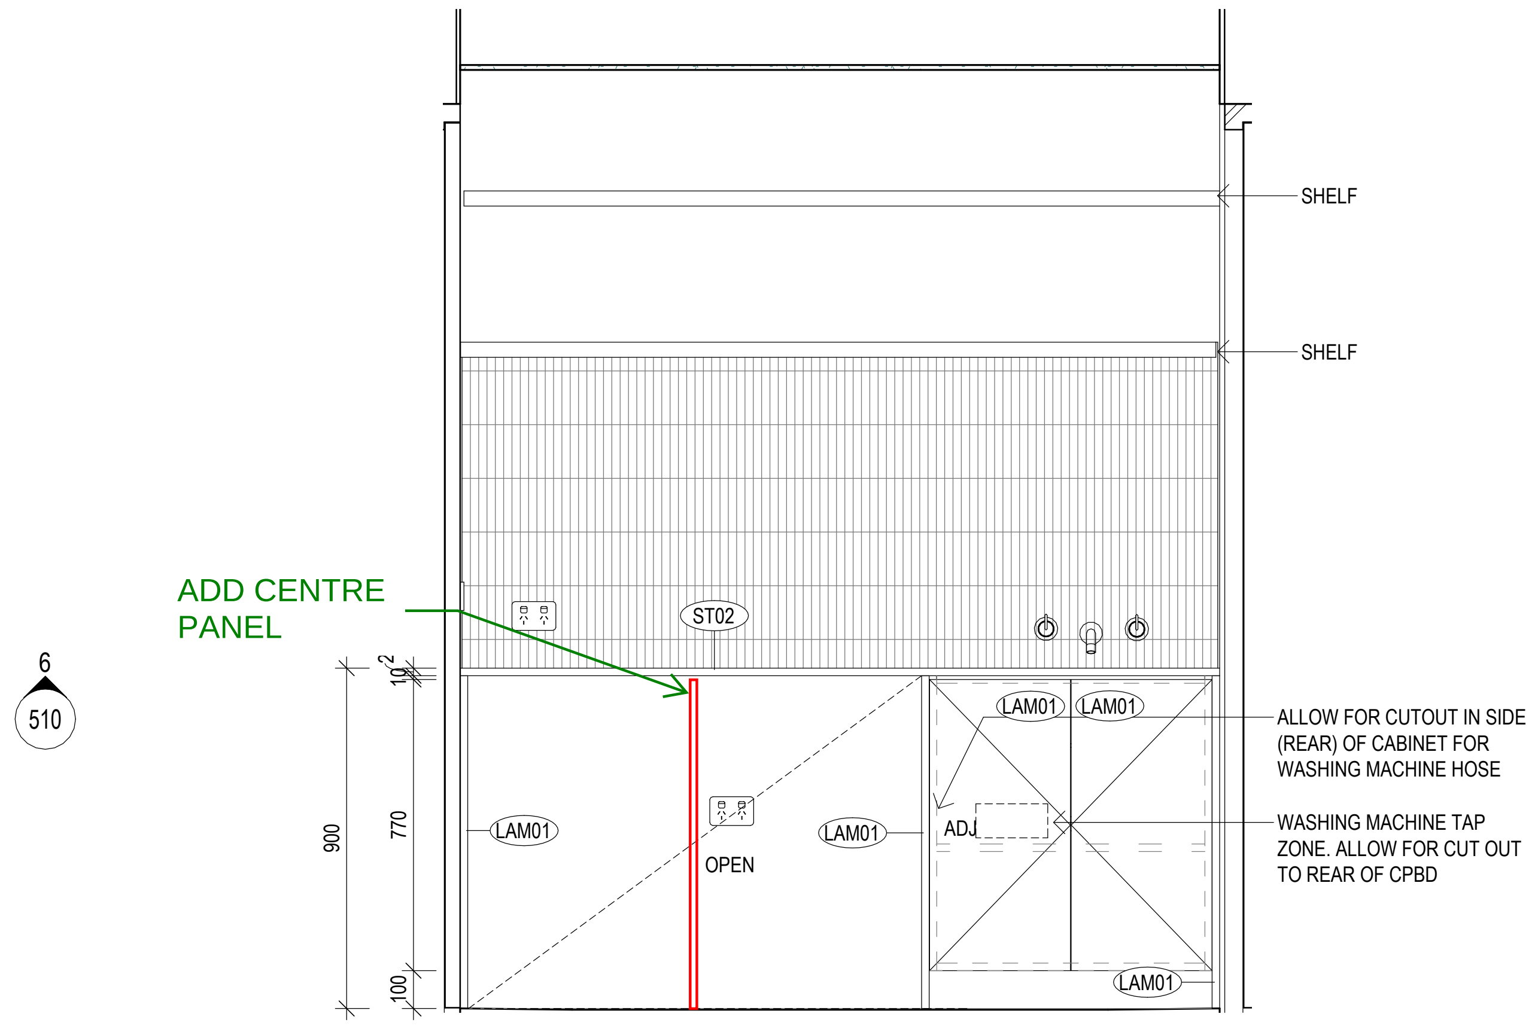
6 510
SHELF
SHELF
ST02
LAM01
OPEN
ADJ
ALLOW FOR CUTOUT IN SIDE (REAR) OF CABINET FOR WASHING MACHINE HOSE
WASHING MACHINE TAP ZONE. ALLOW FOR CUT OUT TO REAR OF CPBD
900
770
100
10
2

ADD CENTRE PANEL

6 / 106 J03 - LAUNDRY ELEVATION
1 : 20

NOTE: PROPRIETARY HANDLES TBC

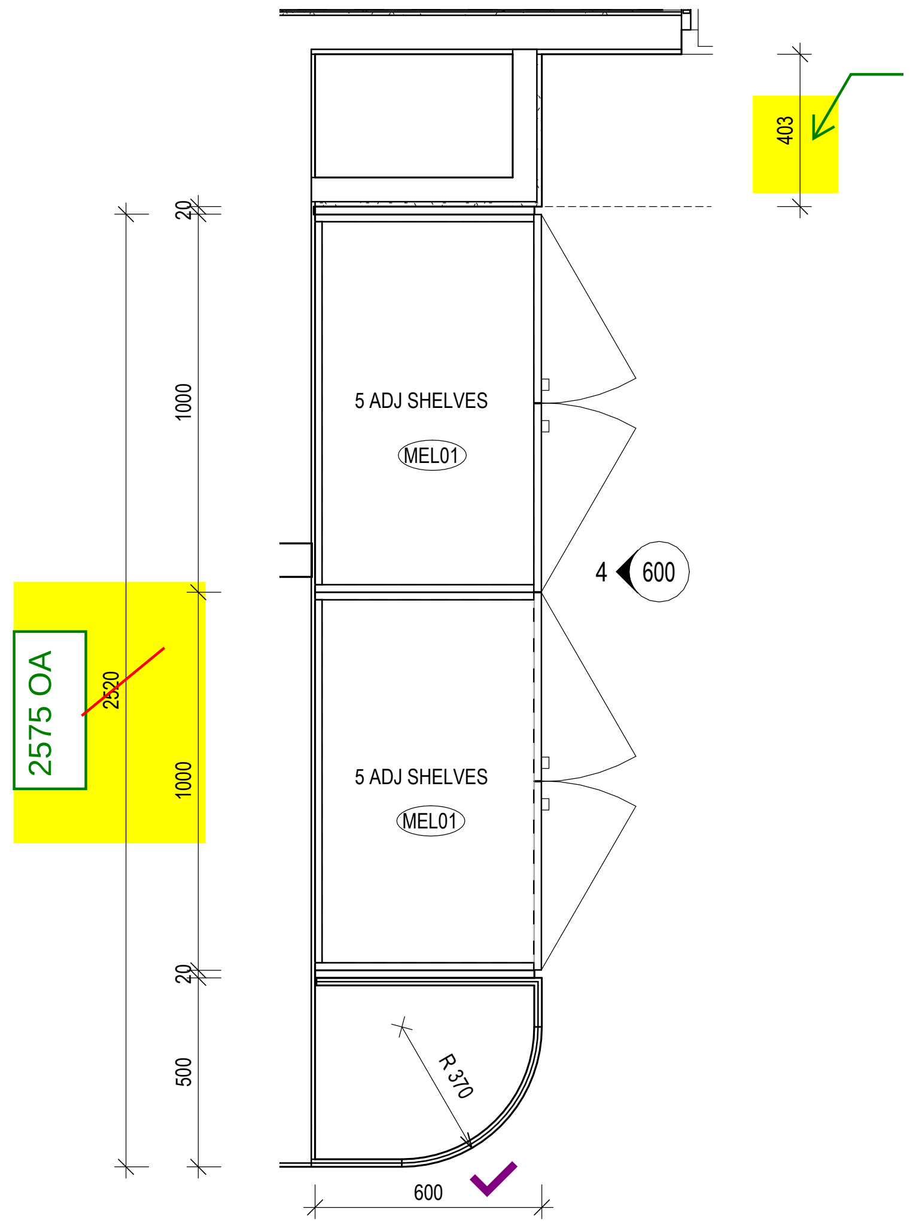

BY BUILDER

3 / 203 J06 - LIVING ROOM JOINERY
1 : 20

2680 CH

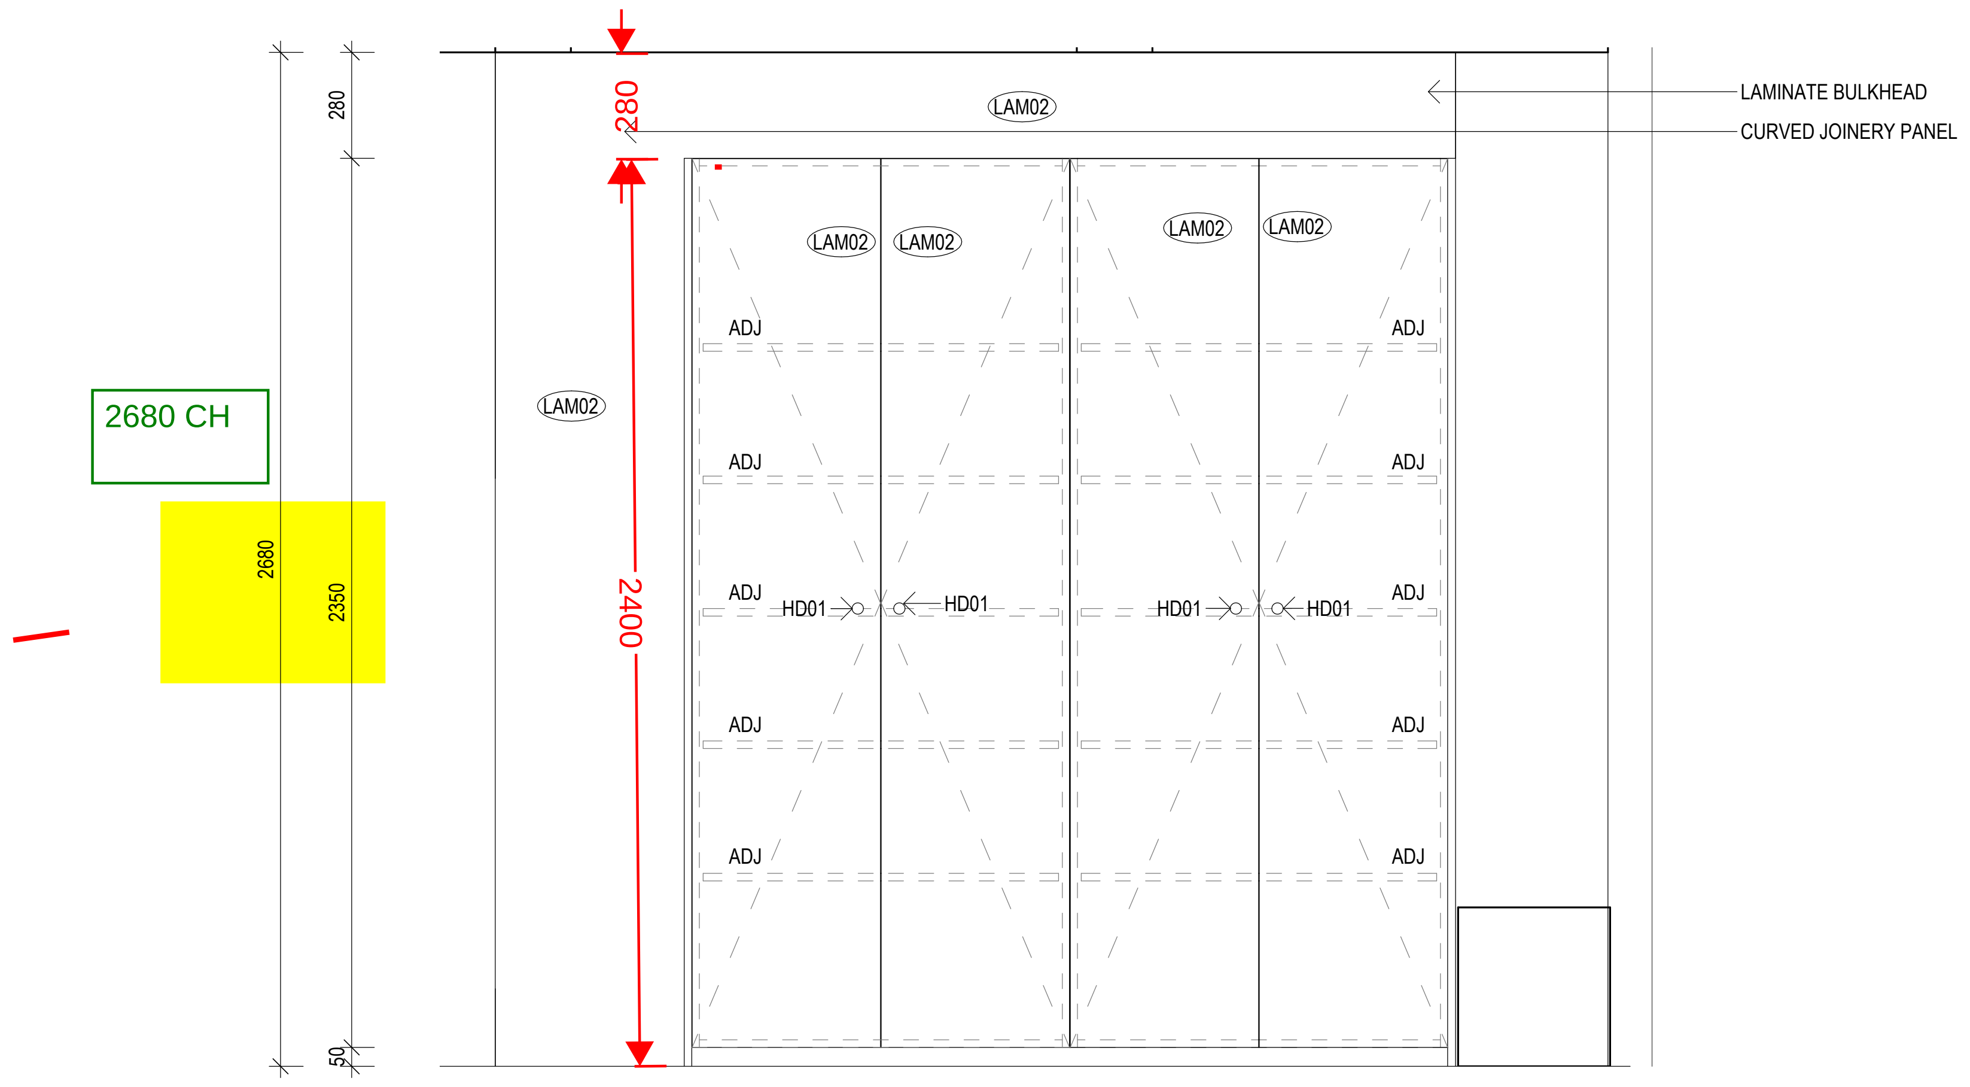

4 / 106 J06 - LIVING ROOM JOINERY - ELEVATION
1 : 20

NOTE: PROPRIETARY HANDLES TBC

16/08/2026 8:17:26 PM C:\Users\KatherineB\OneDrive - nettletontribe\38 Howard\Revit\Concstruction\38 HOWARD_PROPOSED_ARCH (1).rvt

Client

Client Logo

Issue	Description	Date
A	JOINERY ISSUE 1	16-08-2026

Builder

Builders Logo

Project Name
38 Howard Street
Project Address
38 Howard Street, Grange QLD

Key Plan
0 2000 5000

Drawing Title:
JOINERY - J01

Checker: KB
Sheet Size: A1
Scale: 1:10
Drawing Number: **2025-01_600**
Issue: **A**

FINISHES

LAM01 - LAMINEX ELEGANT OAK
LAM02 - LAMINEX ARIES. COLOUR TBC
ST01 - BRECCIATE PRIMAVERA MARBLE
ST02 - YDL MAHAL IVORY
MEL01 - WHITE MELAMINE INTERNAL CARCASS

30/09/2026

MARK UP

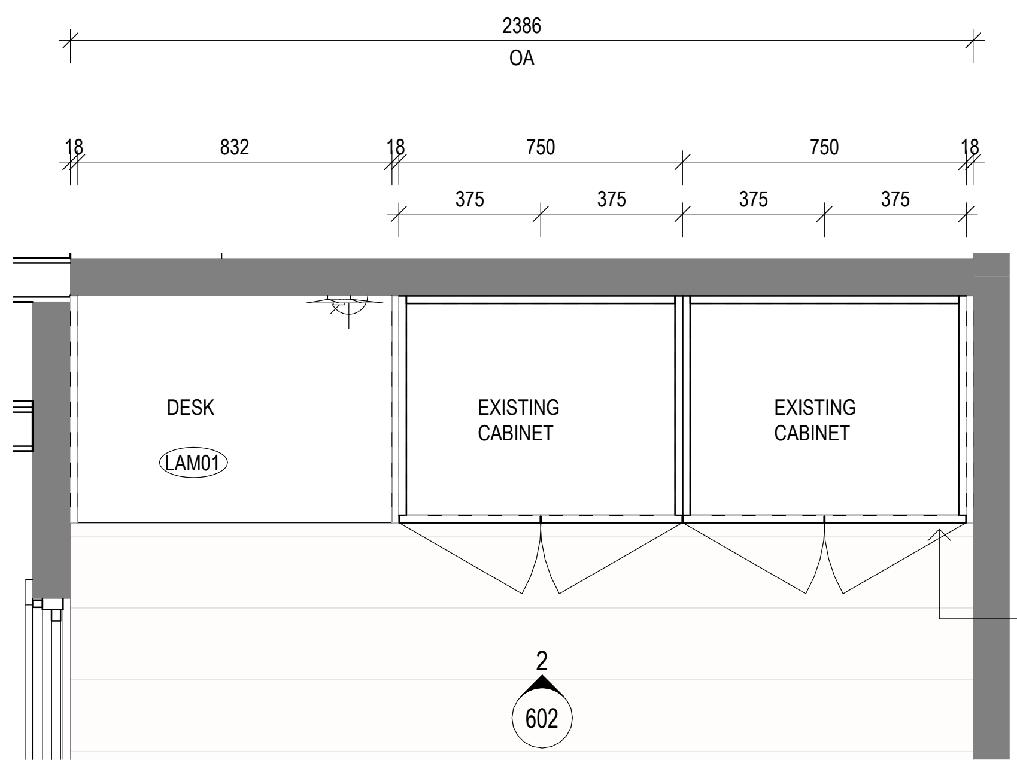

1 / 203 J07 - PLAYROOM JOINERY
1 : 20

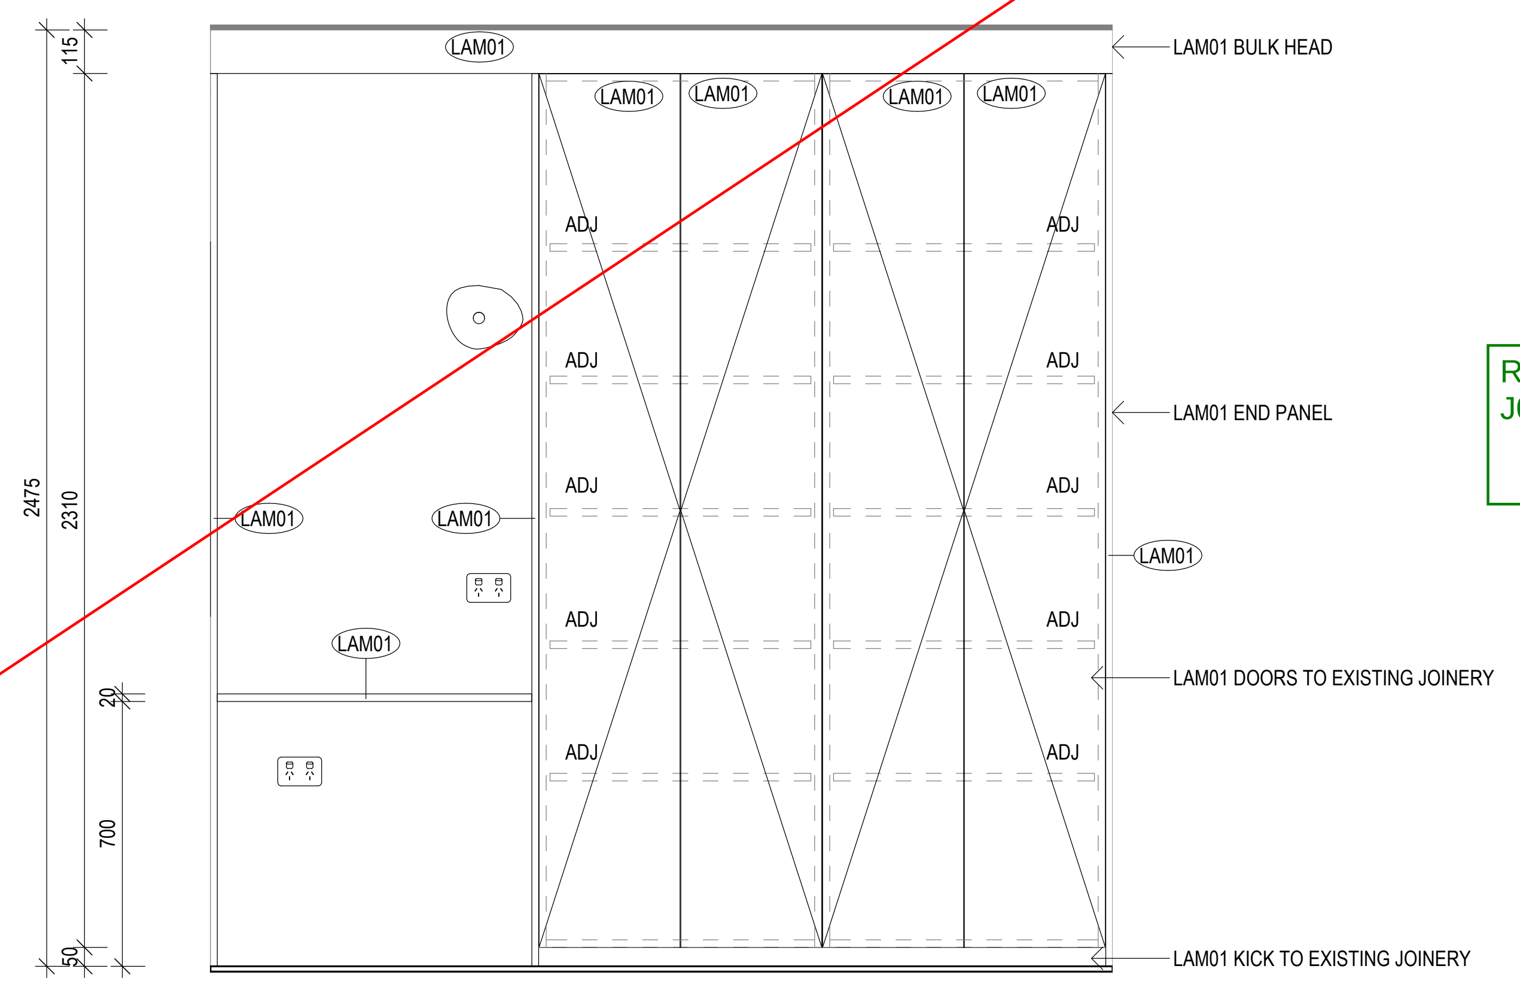
115
2475
2310
20
700
50
LAM01
ADJ
LAM01 BULK HEAD
LAM01 END PANEL
LAM01 DOORS TO EXISTING JOINERY
LAM01 KICK TO EXISTING JOINERY

REMOVE J07 X 2

2 / 104 J07 - PLAYROOM JOINERY - ELEVATION
1 : 20

NOTE: PROPRIETARY HANDLES TBC

PLEASE CONFIRM MINIMUM ROBE SIZE THAT CAN ACCOMMODATE DRAWERS. FRONT HANG RAIL TO BE USED FOR THIS ROBE.

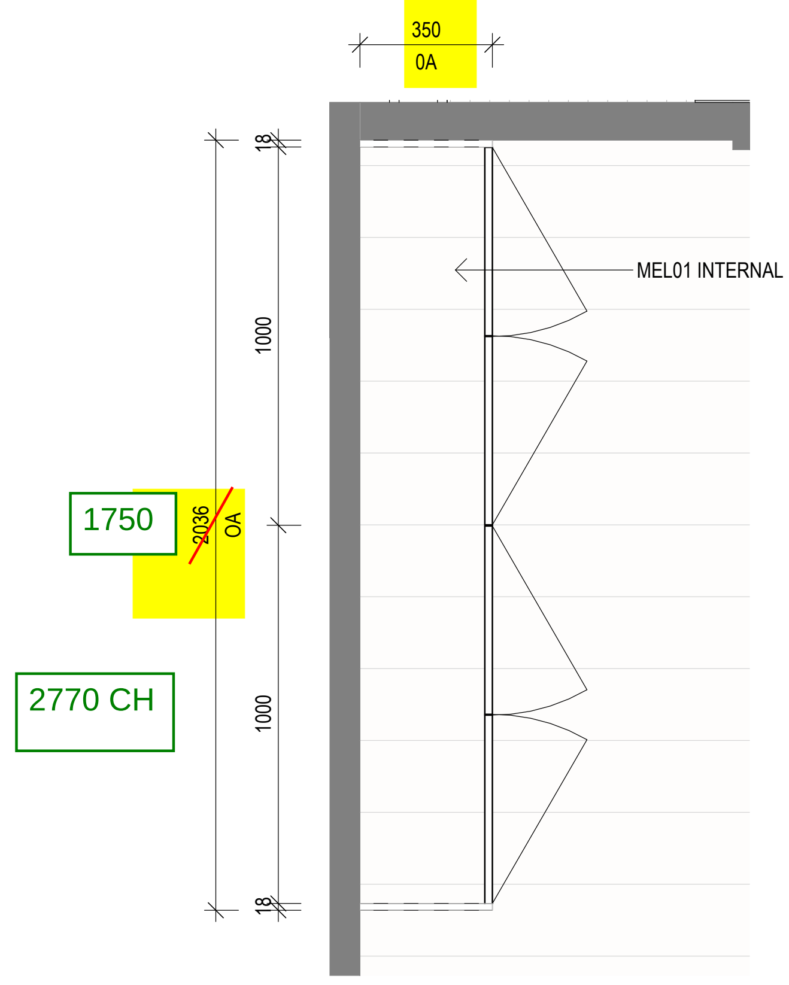

1750

2770 CH

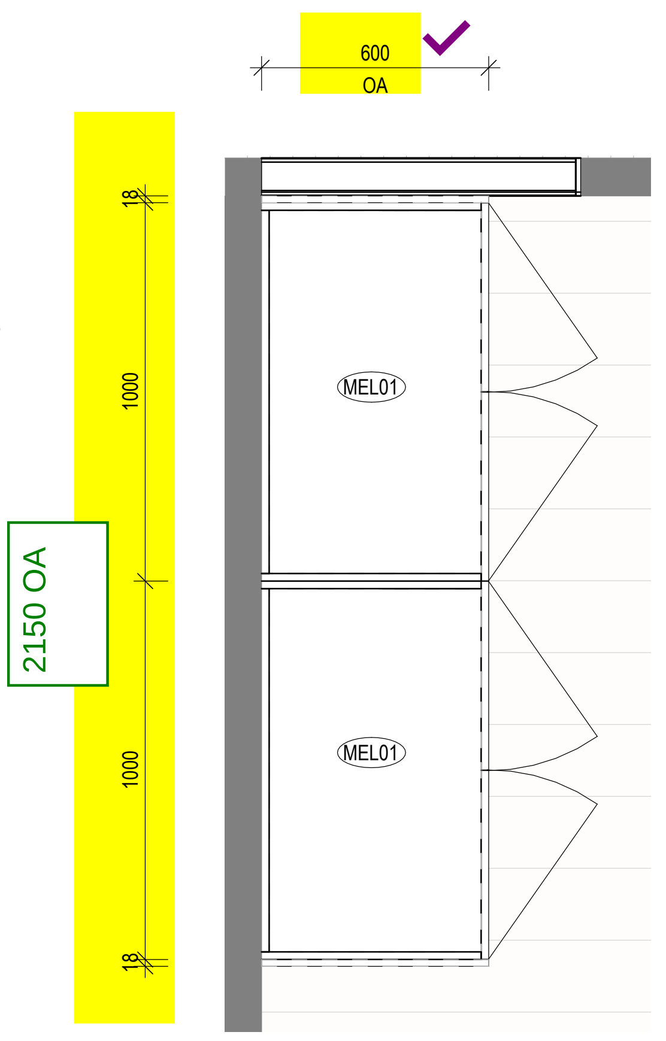

2150 OA

ELEVATION

2770

4 / 203 J08 - BED 2
1 : 20

5 / 203 J08 - BED 3
1 : 20

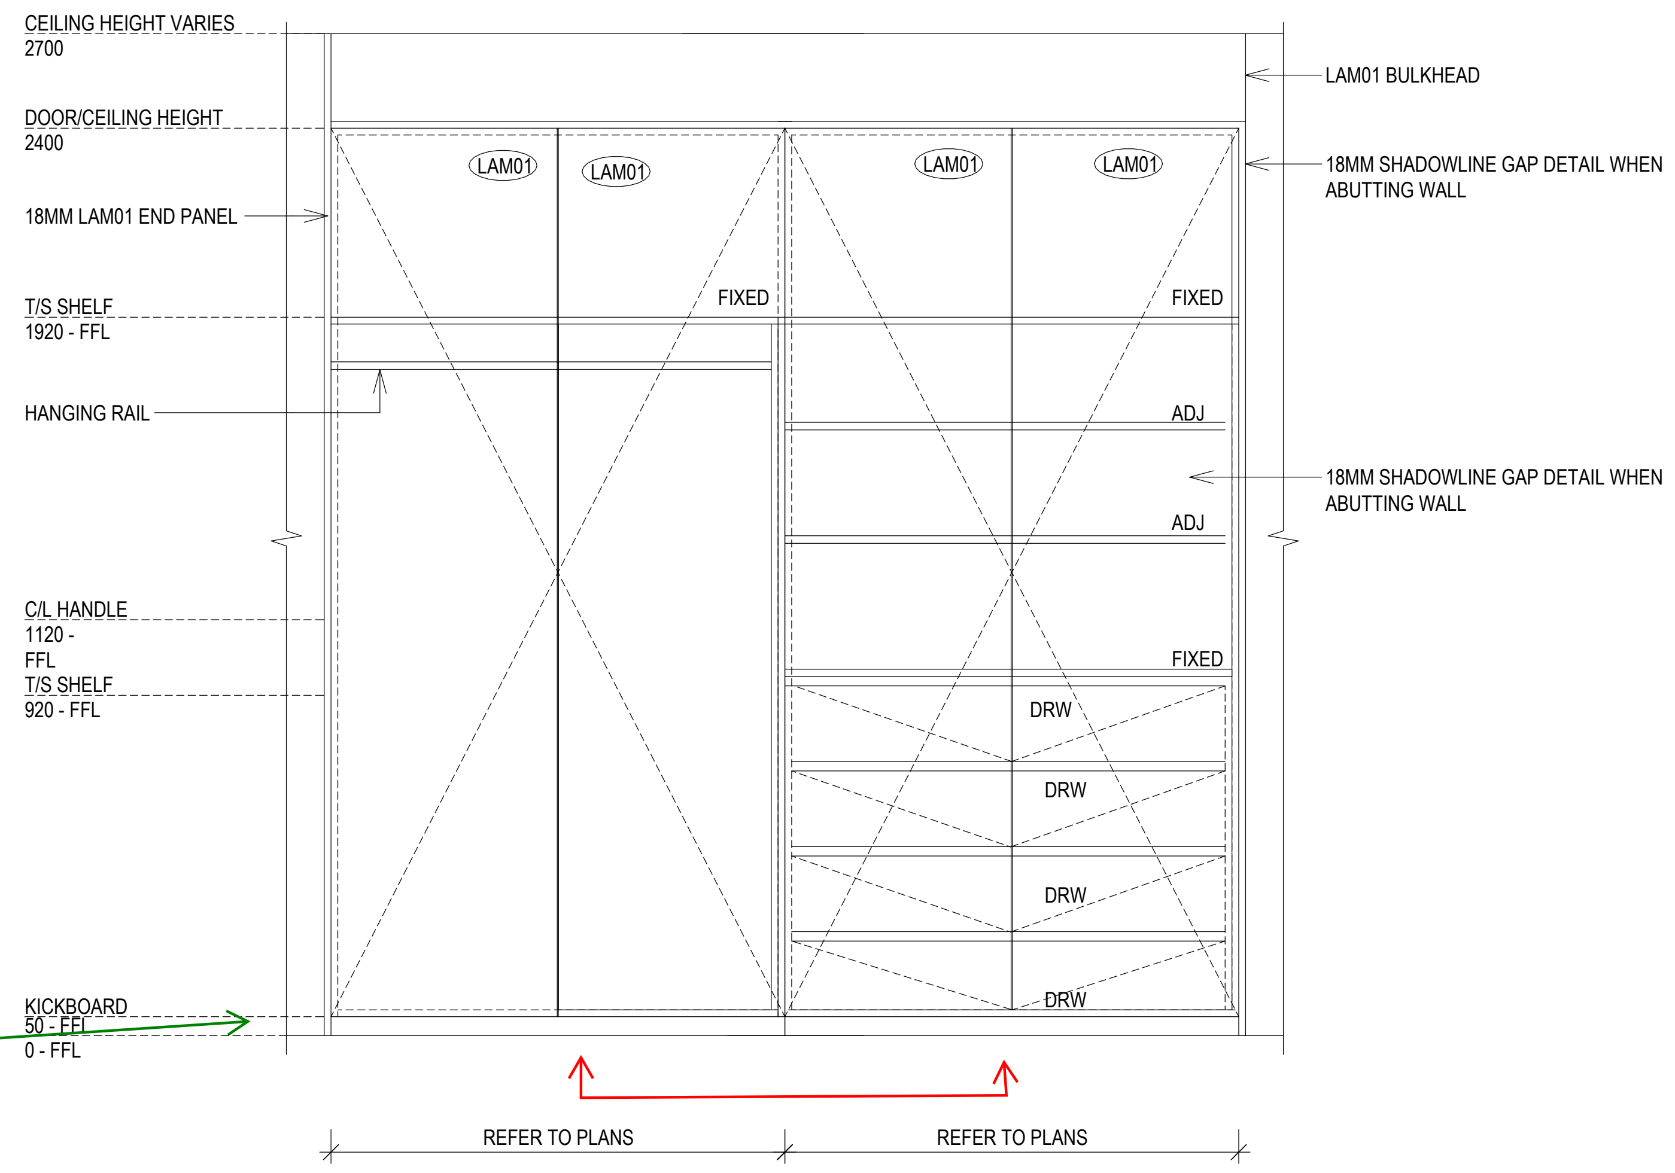

3 J08 - 2 CUPBOARD ROBE - ELEVATION
1 : 20

NOTE: PROPRIETARY HANDLES TBC

ELEVATION TO BE FLIPPED. DRAWERS TO BE AWAY FROM WALL

BED 1 -
2300 OA WIDTH.
600 DEPTH
2770 CH

2 X DRAWERS &
SHELF CUPBOARDS
1 X HANGING
CUPBOARD AS PER
ORIGINAL MARKUP

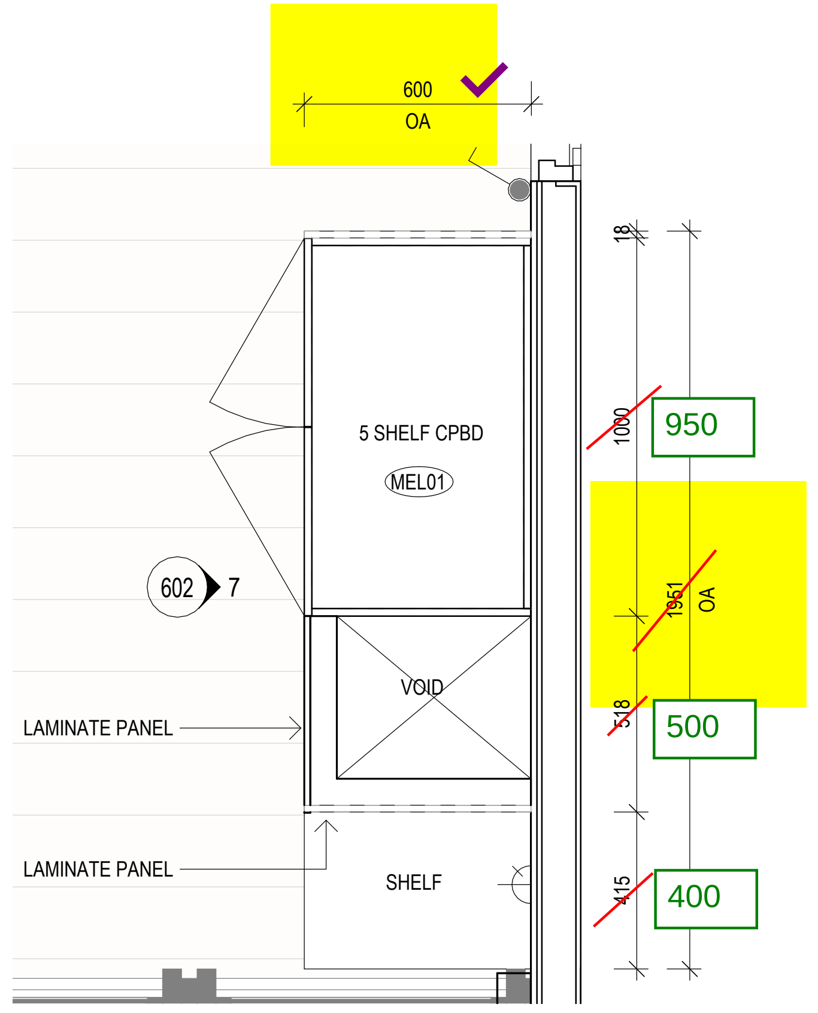

950

500

400

6 / 203 J10 - STORAGE
1 : 20

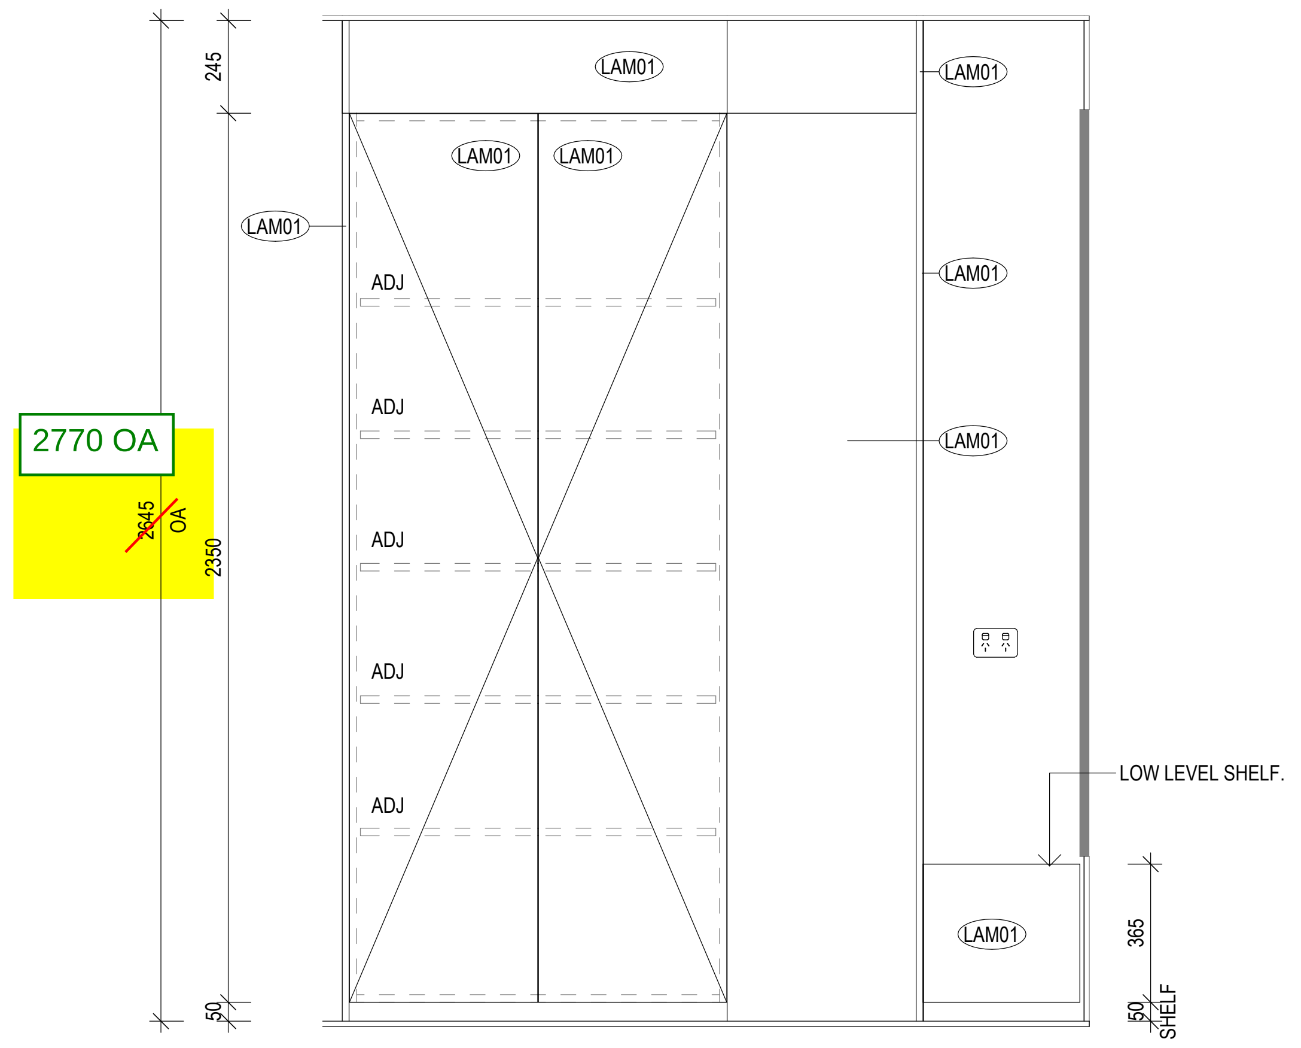

2770 OA

7 / 104 J10 - STORAGE - ELEVATION

NOTE: PROPRIETARY HANDLES TBC

Client

Client Logo

Issue	Description	Date
A	JOINERY ISSUE 1	16-08-2026

Builder

Builders Logo

Project Name
38 Howard Street

Project Address
38 Howard Street, Grange QLD

Key Plan
0 2000 5000

Drawing Title:
JOINERY

Checker: KB
Sheet Size: A1
Scale: 1:20

Drawing Number: **2025-01_602**
Issue: **A**

30/09/2026

MARK UP

FINISHES

LAM01 - LAMINEX ELEGANT OAK
LAM02 - LAMINEX ARIES. COLOUR TBC
ST01 - BRECCIATE PRIMAVERA MARBLE
ST02 - YDL MAHAL IVORY
MEL01 - WHITE MELAMINE INTERNAL CARCASS

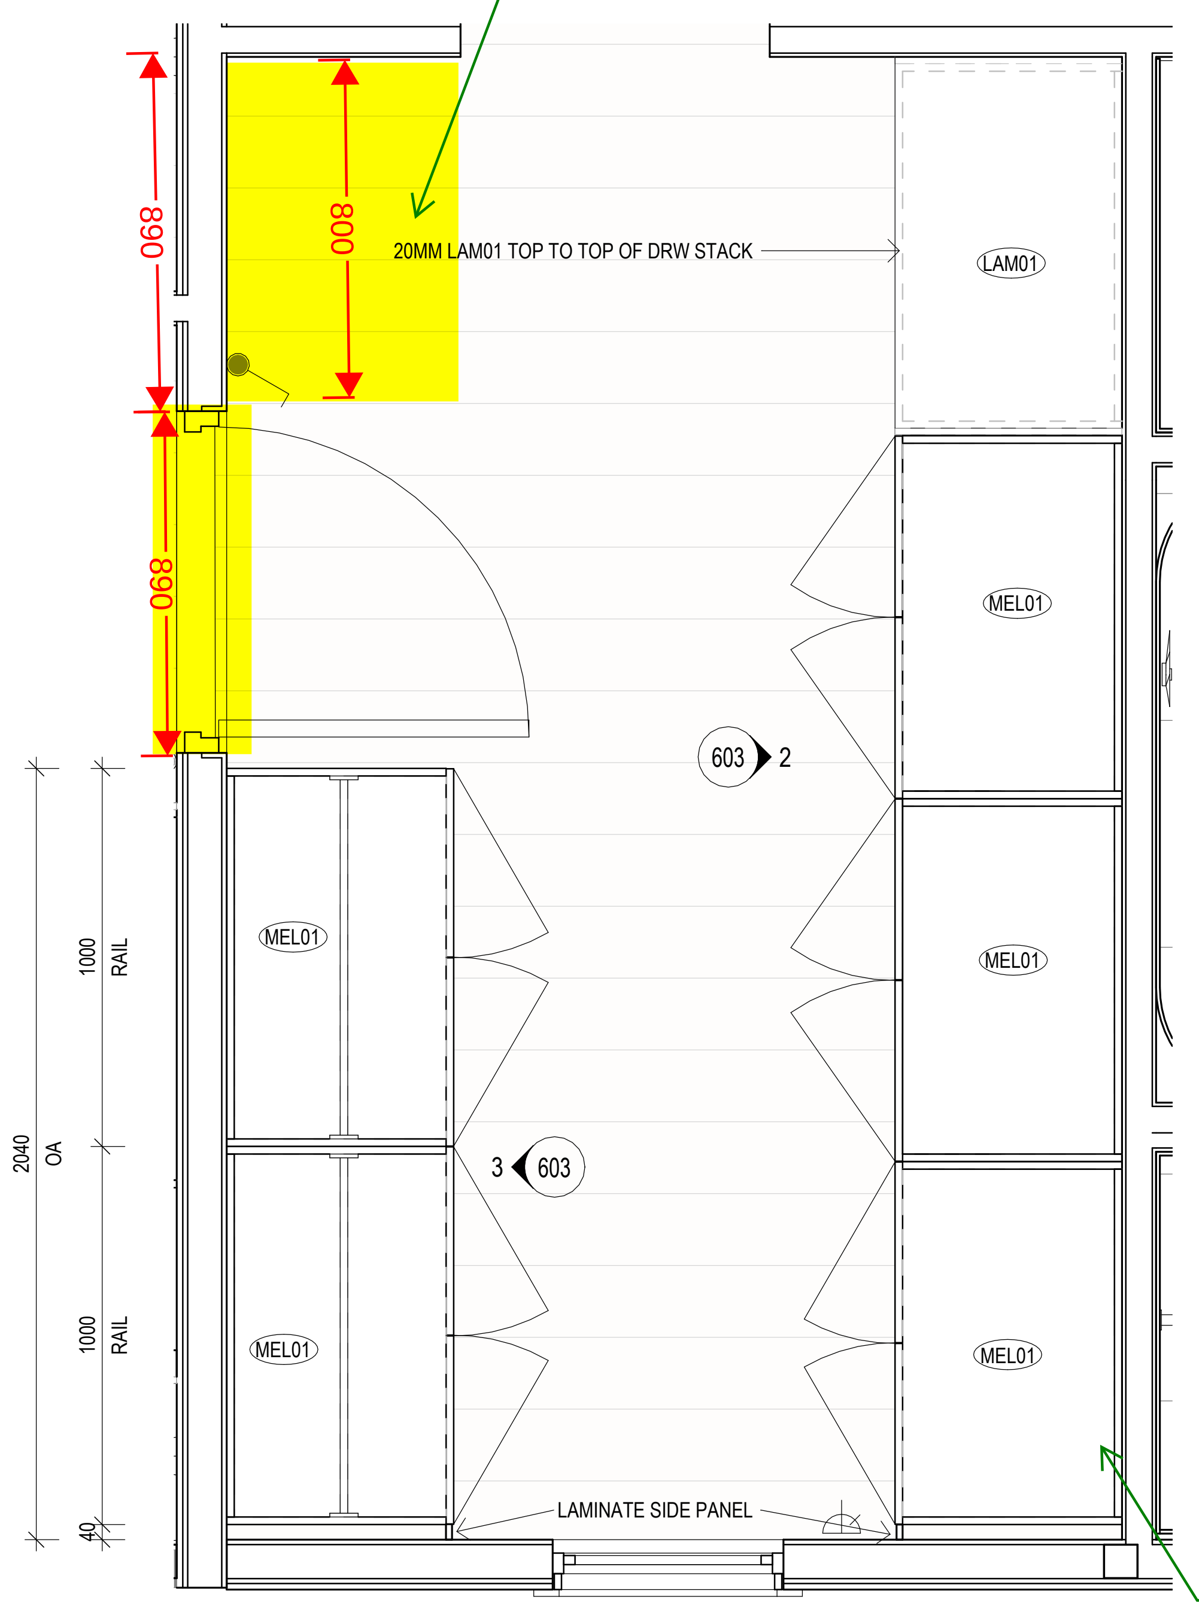

PLEASE ADD IN AN ADDITIONAL CUPBOARD. 5 X ADJUSTABLE SHELVES

HANGING CUPBOARD

1 203 J11 - WIR
1 : 20

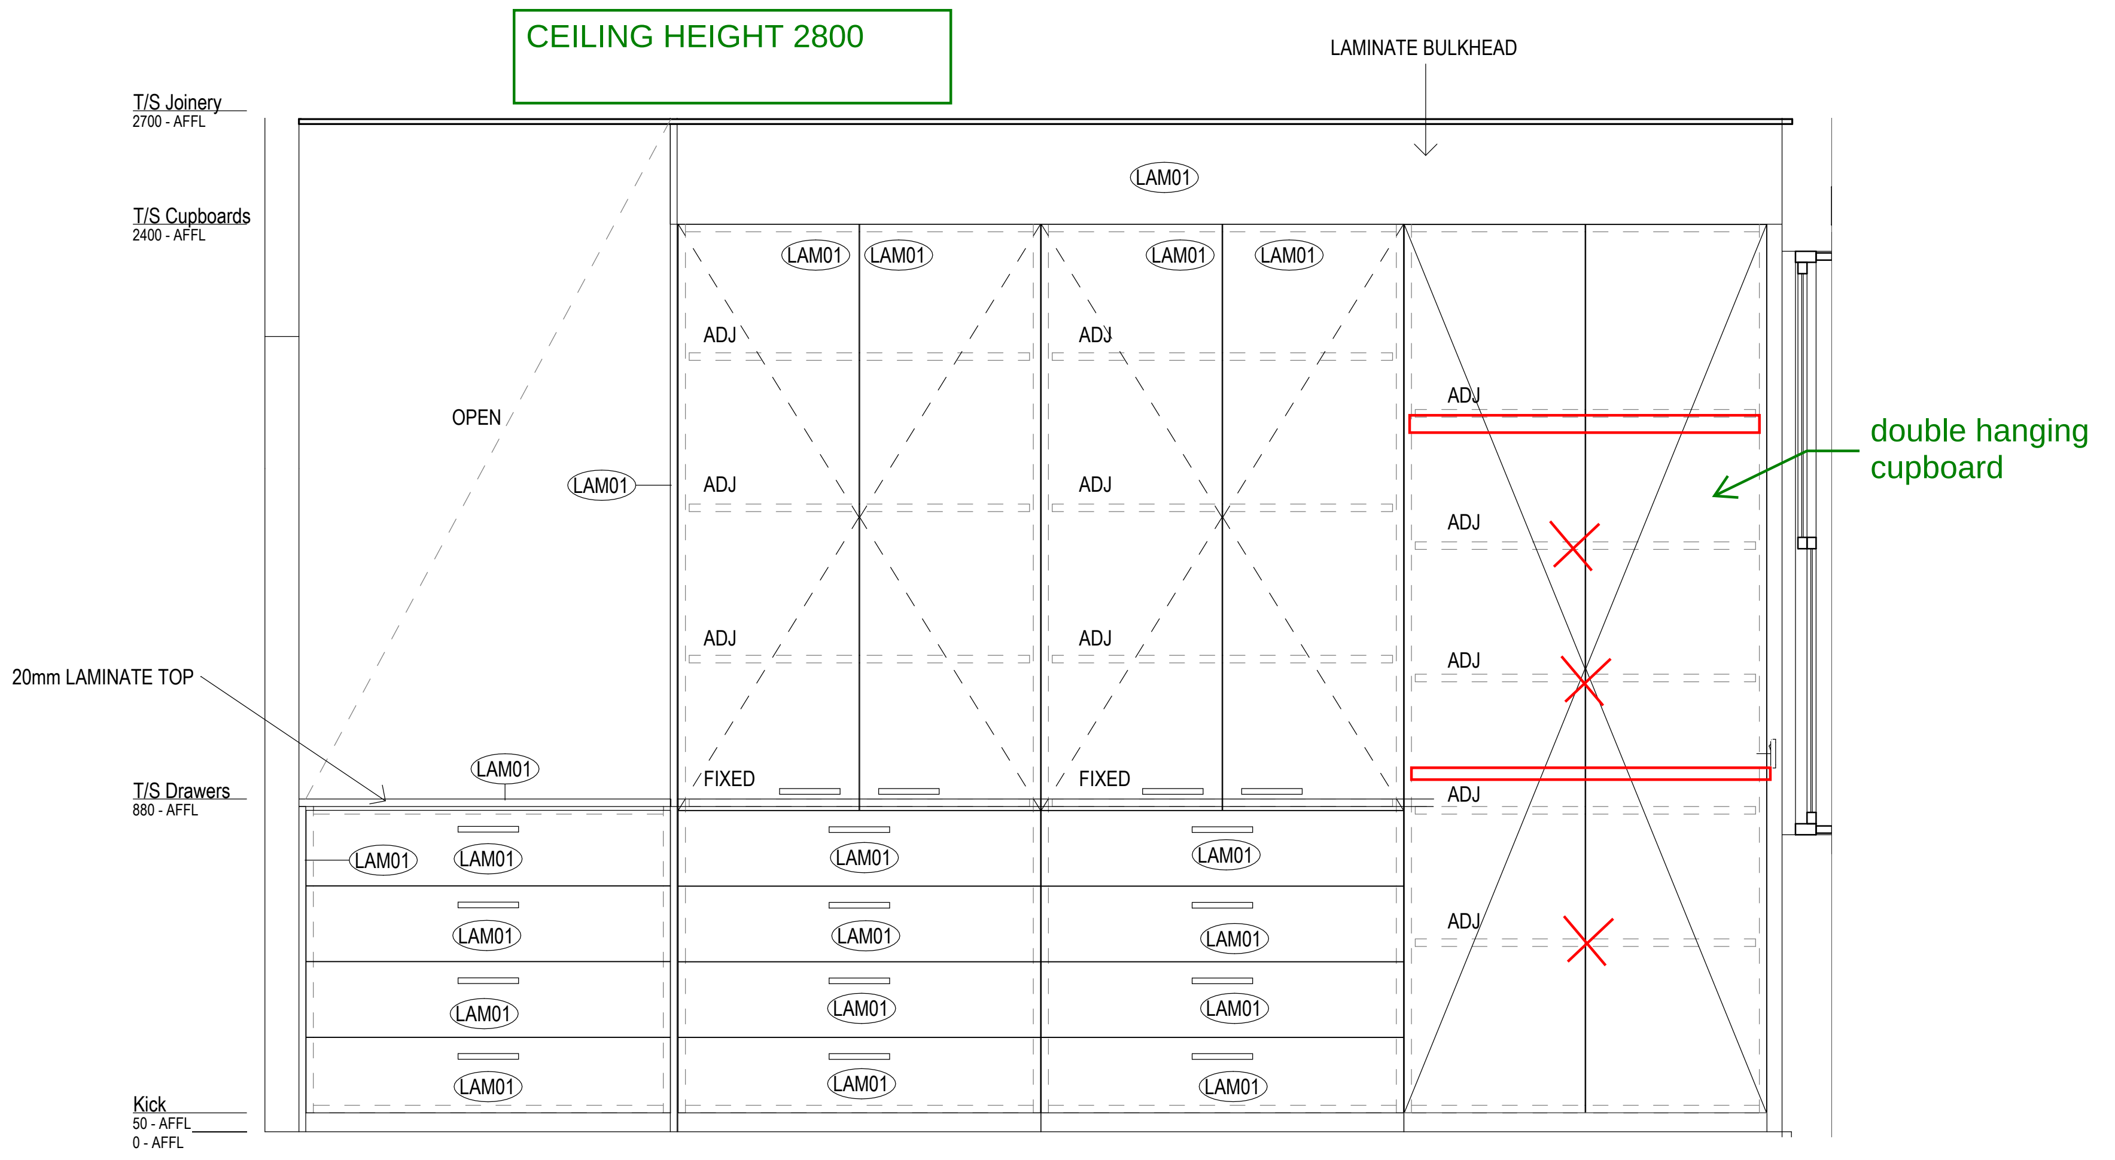

CEILING HEIGHT 2800

double hanging cupboard

2 104 J11 - WIR ELEVATION A
1 : 20

NOTE: PROPRIETARY HANDLES TBC

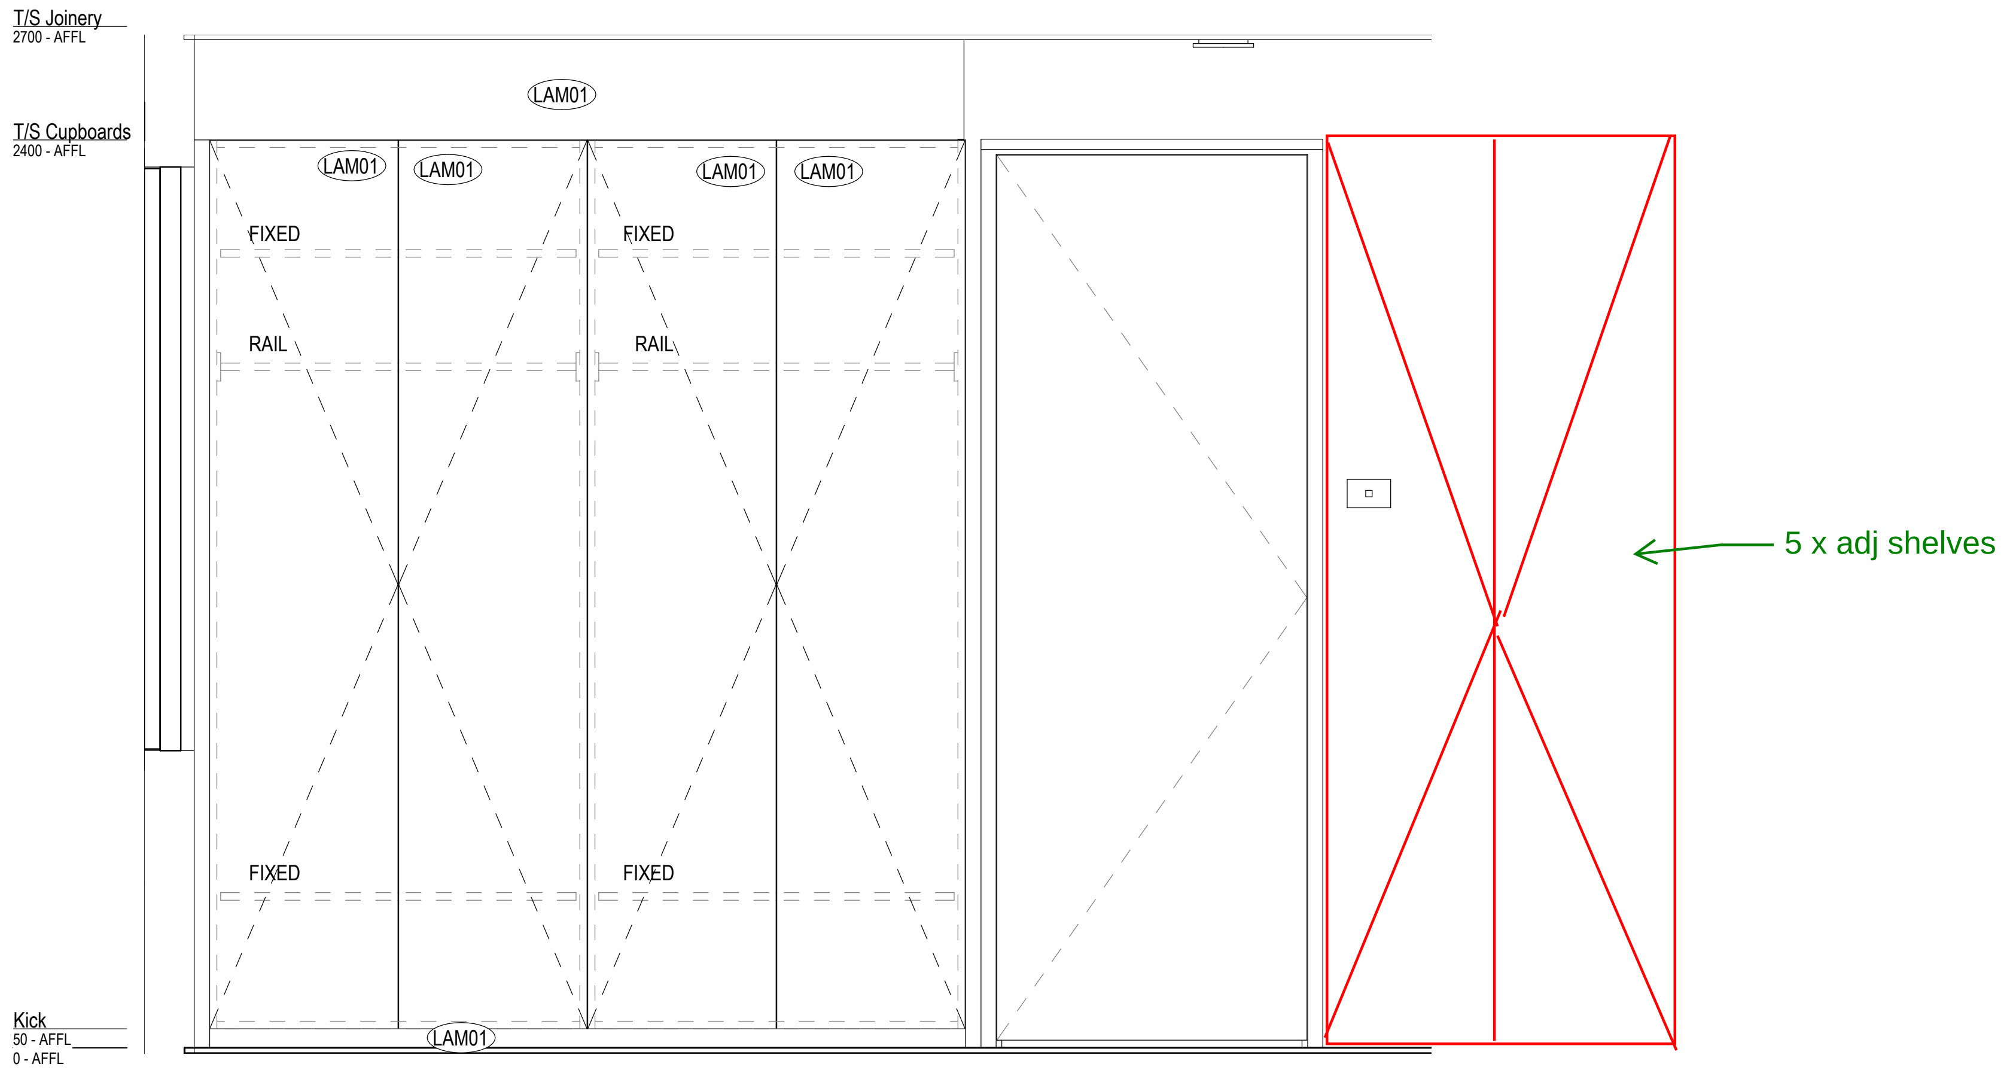

5 x adj shelves

3 104 J11 - WIR - ELEVATION B
1 : 20

NOTE: PROPRIETARY HANDLES TBC

16/08/2026 8:17:30 PM C:\Users\KatherineB\OneDrive - nettletontribe\38 Howard\Revit\Concstruction\38 HOWARD_PROPOSED_ARCH (1).rvt

Client

Client Logo

Issue	Description	Date
A	JOINERY ISSUE 1	16-08-2026

Builder

Builders Logo

Project Name
38 Howard Street
Project Address
38 Howard Street, Grange QLD

Key Plan
0 400 1000

Drawing Title:
JOINERY

Checker: **KB**
Sheet Size: **A1**
Scale: **1:20**
Drawing Number: **2025-01_603**
Issue: **A**

30/09/2026

MARK UP

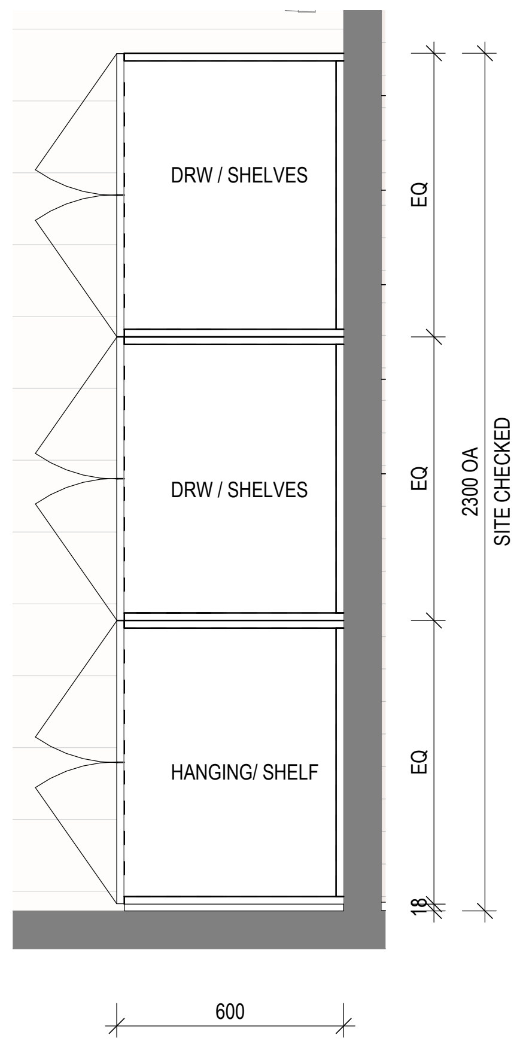

3
203
J09 - BED 1
1 : 20

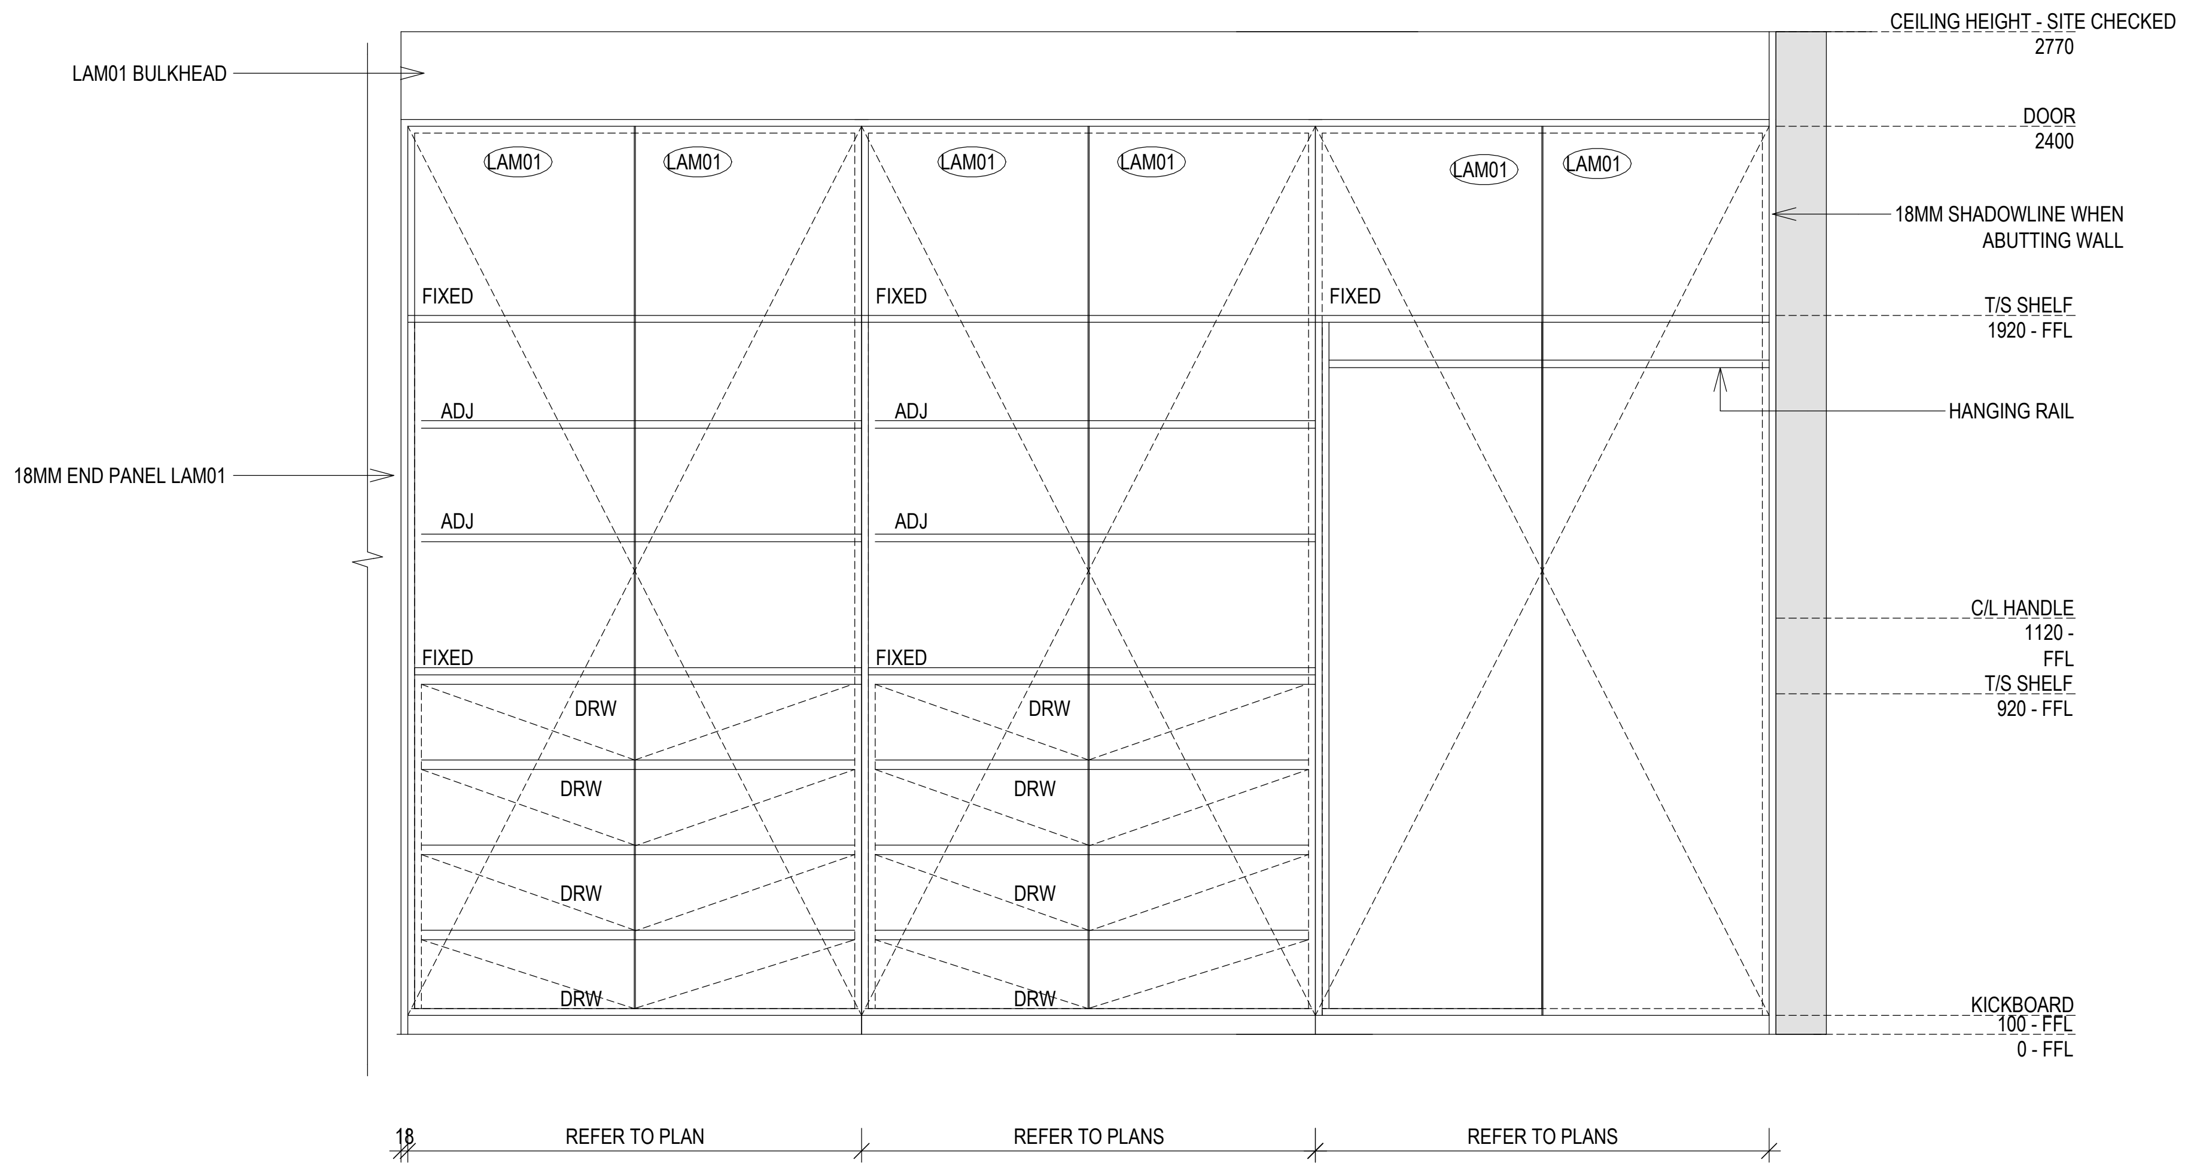

4
J09 - 2 CUPBOARD ROBE - ELEVATION
1 : 20

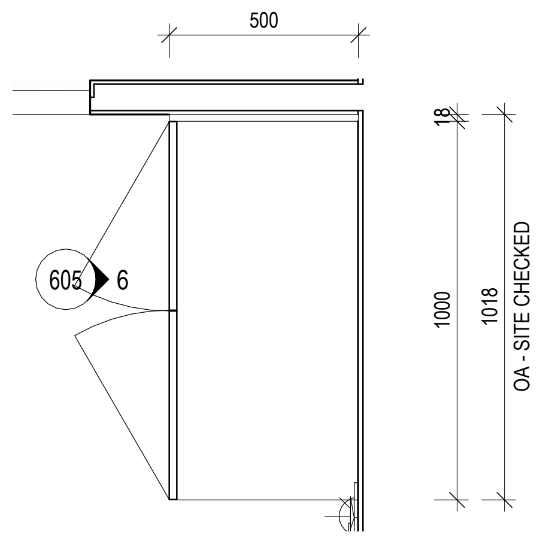

5
203
J12 -MASTER STORAGE
1 : 20

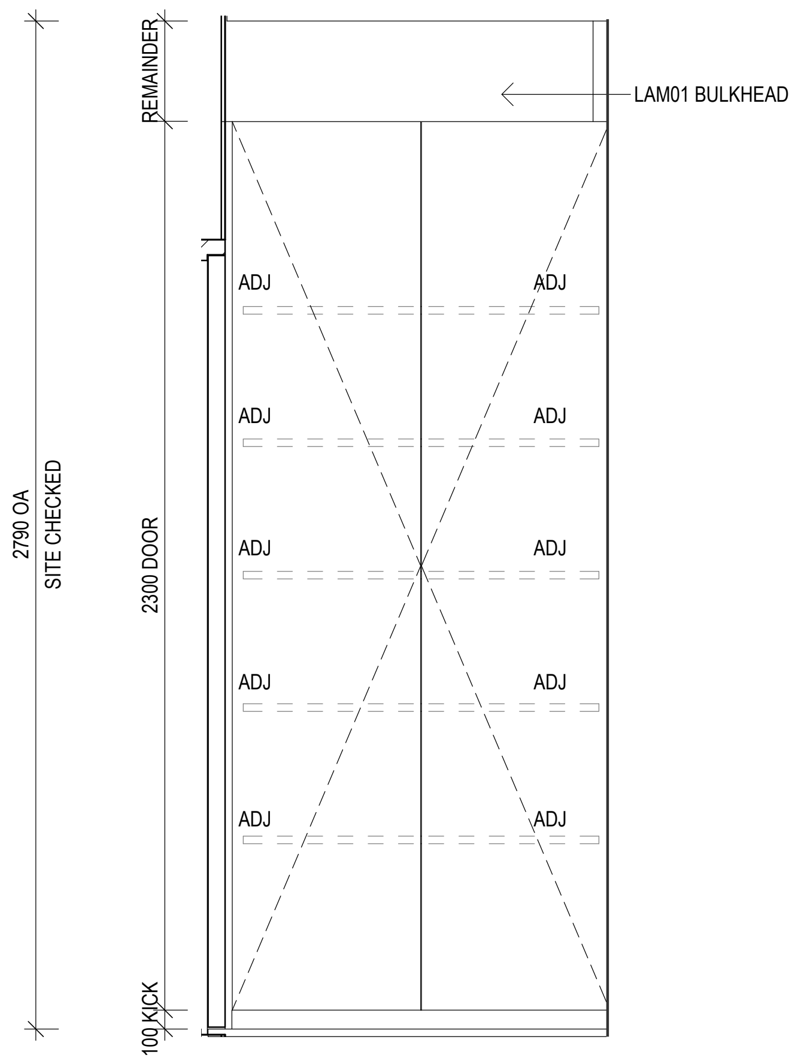

6
104
J12 - ELEVATION
1 : 20

28/09/2026 2:01:48 PM

C:\Users\KatherineB\OneDrive - nettletontribe\38 Howard\Revit\Concstruction\38 HOWARD_PROPOSED_ARCH (1).rvt

Client

Client Logo

Issue	Description	Date
A	JOINERY ISSUE 2	28-09-2026

Builder and/or subcontractors shall verify all project dimensions before commencing on-site work or off-site fabrication. Figured dimensions shall take precedence over scaled dimensions.

Builder

Builders Logo

Project Name
38 Howard Street

Project Address
38 Howard Street, Grange QLD

Key Plan
0 2000 5000

Drawing Title:
JOINERY

Checker: **KB**
Sheet Size: **A1**
Scale: **1:20**
Drawing Number: **2025-01_605**
Issue: **A**