Bed 1 J09 Plan


1 : 20

This shop drawing has been examined for compliance with architectural design intent only and does not relieve either builder or subcontractor(s) from their obligations under the Contract, nor shall be deemed to be authorisation for any variation.

- [ ] a. Reviewed, no comments
- [x] b. Reviewed, revise as noted
- [ ] c. Reviewed, revise and resubmit
- [ ] d. Not reviewed

katherine blackham — signed

29/10/2026 — date

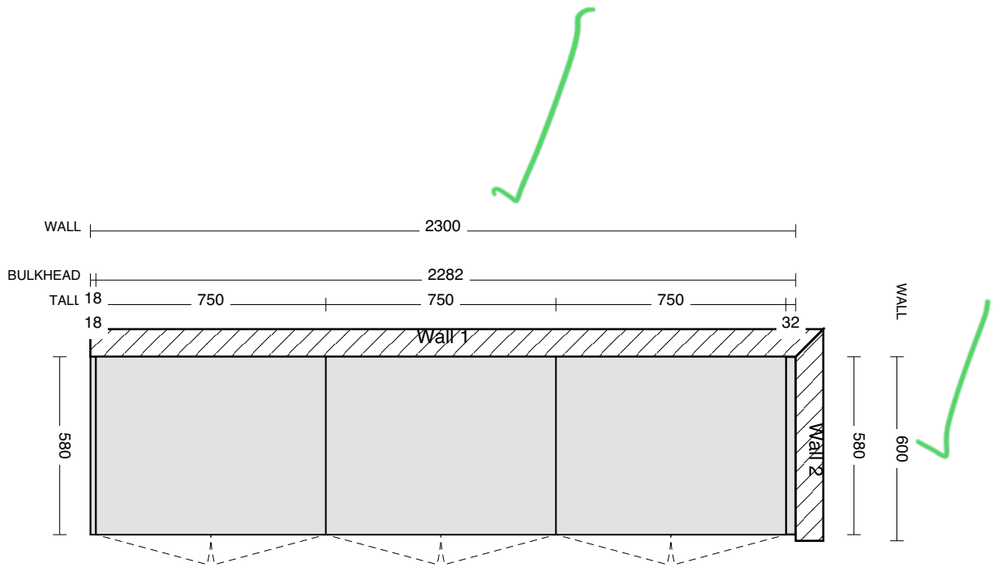

SPECIFICATIONS - Bed 1 J09
RHK6581 Lee Smith

FRONTS + PANELS
Laminex 18mm ABS Grain - Elegant Oak
Panels: -

HANDLES
Client supplied - undrilled

CARCASS
Whiteboard 16.5mm

DRAWERS
Drawer box: DTC Dragon Pro


HARDWARE
Hinges: Blum
Runners: DTC Dragon Pro


Client Approved Signature : ..... Date : .....

Kitchens By Resident Hero 32 Gateway Drive Phone: 0754471077 mark@residenthero.com.au www.residenthero.com.au	RHK6581 Lee Smith	**Scale: 1 : 20**	**Sheet 1 of 3**
	Bed 1 J09	Do not scale off this drawing.	Drawn By:
	38 Howard St, Grange QLD		Date: 26/10/26

Bed 1 J09 Elevation Wall 1 1 : 20

bulkhead to finish flush with side

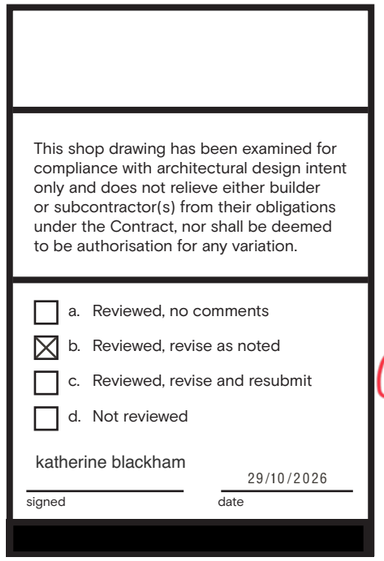

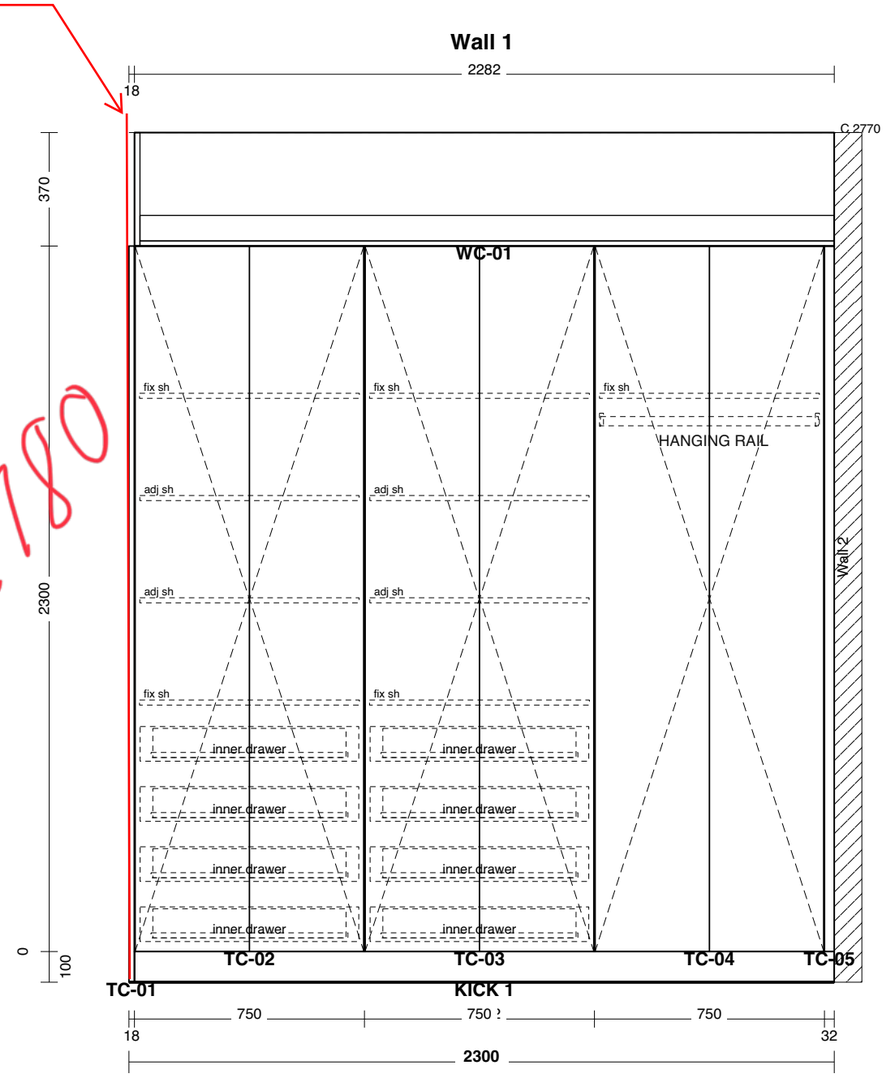

Client Approved Signature : ..... Date : .....

Kitchens By Resident Hero 32 Gateway Drive Phone: 0754471077 mark@residenthero.com.au www.residenthero.com.au	RHK6581 Lee Smith	**Scale: 1 : 20**	**Sheet 2 of 3**
	Bed 1 J09	Do not scale off this drawing.	Drawn By:
	38 Howard St, Grange QLD		Date: 26/10/26


Bed 1 J09 3D NTS

This shop drawing has been examined for compliance with architectural design intent only and does not relieve either builder or subcontractor(s) from their obligations under the Contract, nor shall be deemed to be authorisation for any variation.

- ☐ a. Reviewed, no comments
- ☒ b. Reviewed, revise as noted
- ☐ c. Reviewed, revise and resubmit
- ☐ d. Not reviewed

katherine blackham — signed

29/10/2026 — date

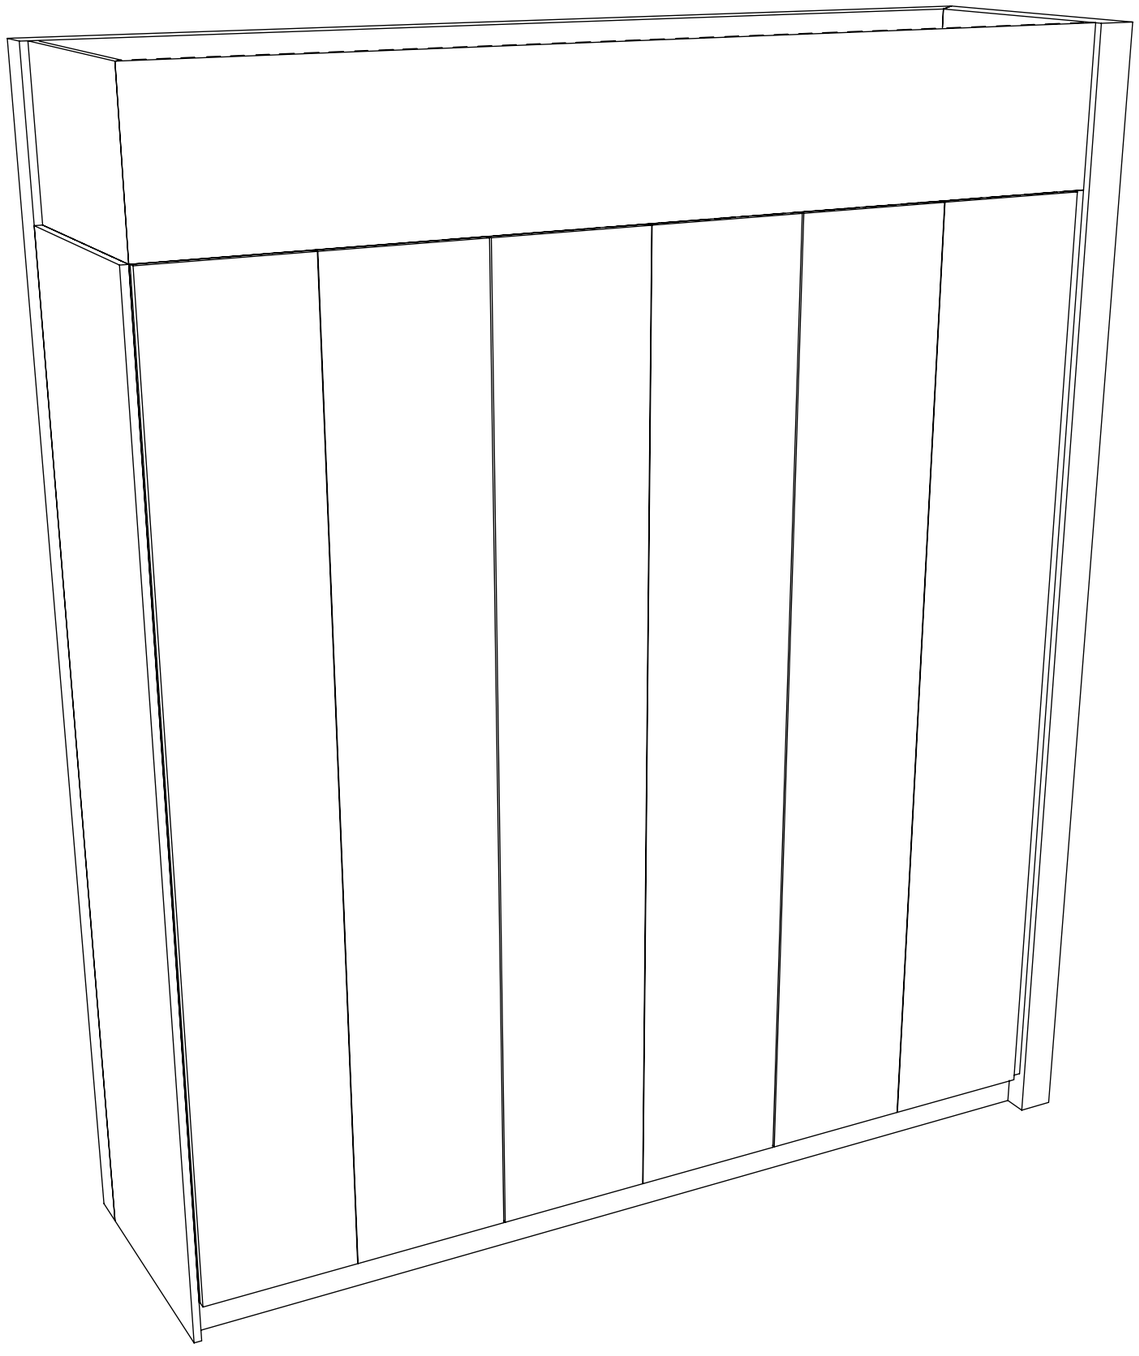

Client Approved Signature : ..... Date : .....

Kitchens By Resident Hero 32 Gateway Drive Phone: 0754471077 mark@residenthero.com.au www.residenthero.com.au	RHK6581 Lee Smith	**Scale: NTS**	**Sheet 3 of 3**
	Bed 1 J09	Do not scale off this drawing.	Drawn By:
	38 Howard St, Grange QLD		Date: 26/10/26