
Bed 2 J08 Plan 1 : 20

#Wall is 25mm out of level.

30mm Scribe tag

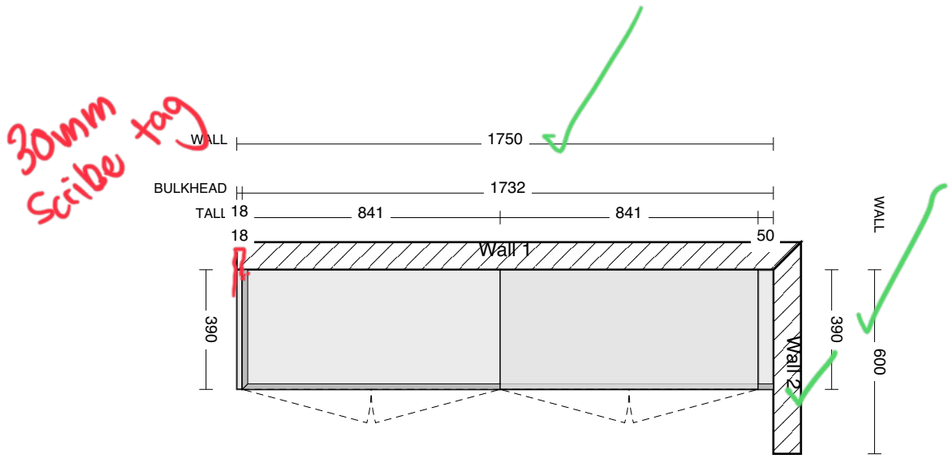

SPECIFICATIONS - Bed 2 J08
RHK6581 Lee Smith

FRONTS + PANELS
Laminex 18mm ABS Grain - Elegant Oak
Panels: -

HANDLES
Client supplied - undrilled

CARCASS
Whiteboard 16.5mm


DRAWERS
Drawer box: DTC Dragon Pro

HARDWARE
Hinges: Blum
Runners: DTC Dragon Pro

Client Approved Signature : ..... Date : .....

Kitchens By Resident Hero 32 Gateway Drive Phone: 0754471077 mark@residenthero.com.au www.residenthero.com.au	RHK6581 Lee Smith	**Scale: 1 : 20**	**Sheet 1 of 3**
	Bed 2 J08	Do not scale off this drawing.	Drawn By:
	38 Howard St, Grange QLD		Date: 26/10/26

Bed 2 J08 Elevation Wall 1 1 : 20

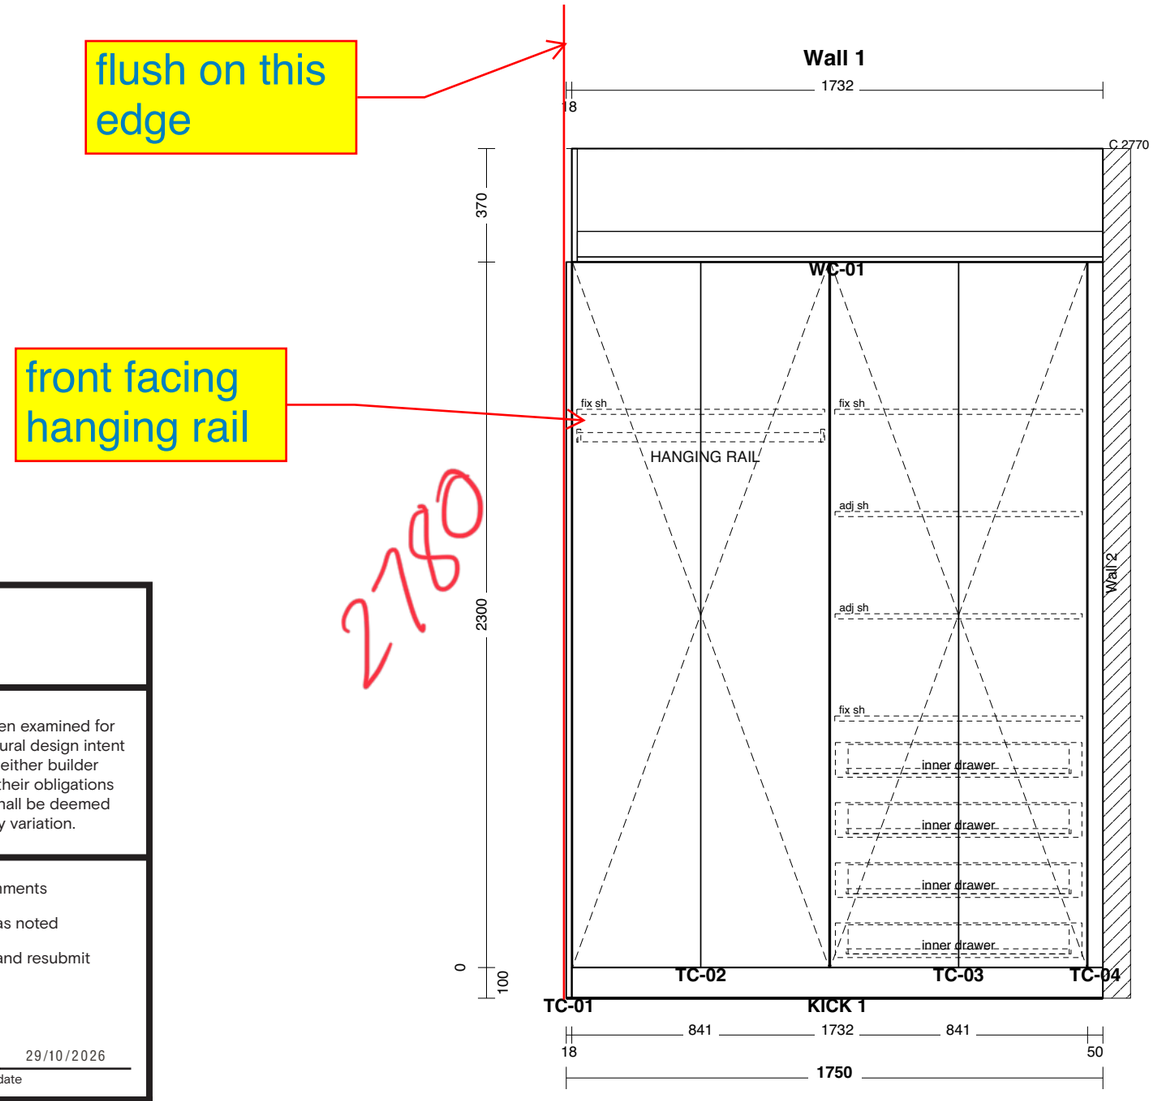

This shop drawing has been examined for compliance with architectural design intent only and does not relieve either builder or subcontractor(s) from their obligations under the Contract, nor shall be deemed to be authorisation for any variation.

- [ ] a. Reviewed, no comments
- [x] b. Reviewed, revise as noted
- [ ] c. Reviewed, revise and resubmit
- [ ] d. Not reviewed


katherine blackham — signed

29/10/2026 — date

Client Approved Signature : ..... Date : .....

Kitchens By Resident Hero 32 Gateway Drive Phone: 0754471077 mark@residenthero.com.au www.residenthero.com.au	RHK6581 Lee Smith	**Scale: 1 : 20**	**Sheet 2 of 3**
	Bed 2 J08	Do not scale off this drawing.	Drawn By:
	38 Howard St, Grange QLD		Date: 26/10/26

Bed 2 J08 3D NTS

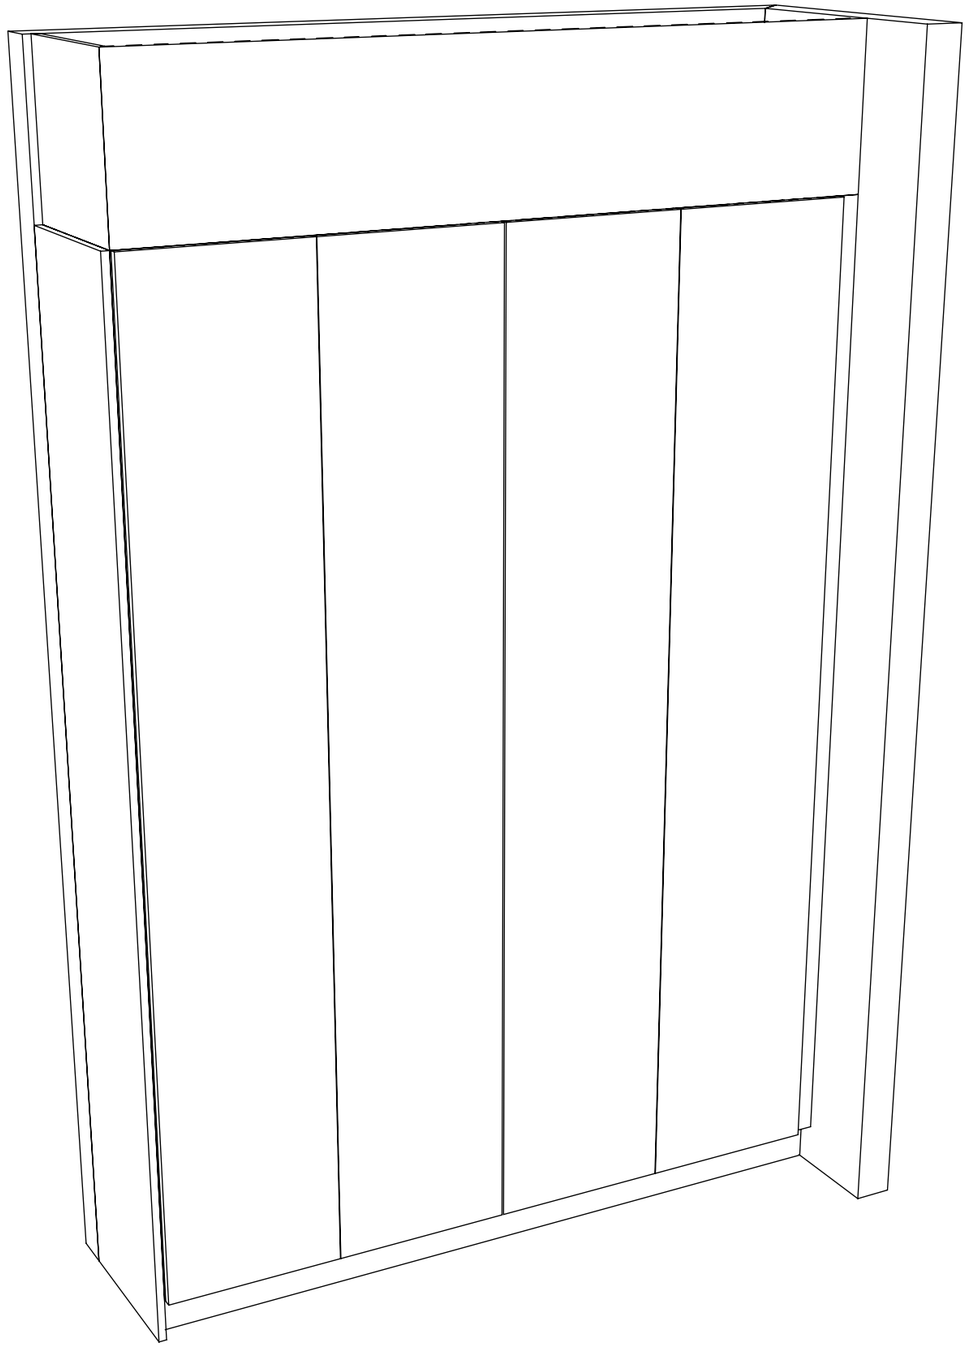

This shop drawing has been examined for compliance with architectural design intent only and does not relieve either builder or subcontractor(s) from their obligations under the Contract, nor shall be deemed to be authorisation for any variation.

- ☐ a. Reviewed, no comments
- ☒ b. Reviewed, revise as noted
- ☐ c. Reviewed, revise and resubmit
- ☐ d. Not reviewed

katherine blackham — signed

29/10/2026 — date

Client Approved Signature : ..... Date : .....

Kitchens By Resident Hero 32 Gateway Drive Phone: 0754471077 mark@residenthero.com.au www.residenthero.com.au	RHK6581 Lee Smith	**Scale: NTS**	**Sheet 3 of 3**
	Bed 2 J08	Do not scale off this drawing.	Drawn By:
	38 Howard St, Grange QLD		Date: 26/10/26