SPECIFICATIONS - Kitchen J05 + Butler's J04
RHK6581 Lee Smith

FRONTS + PANELS
Laminex 18mm ABS Grain - Elegant Oak
Panels: LX Abs Grain 18mm – Elegant Oak, Whiteboard 16.5mm

HANDLES
Linear sharknose strip 35

CARCASS
Whiteboard 16.5mm

DRAWERS
Drawer box: DTC Dragon Pro - Whiteboard 16.5mm

HARDWARE
Hinges: Blum
Runners: DTC Dragon Pro 500mm
Bin: Nikpol Teramo 74L

APPLIANCES + SINKS - Kitchen J05 + Butler's J04
RHK6581 Lee Smith

SINK
Double Bowl Undermount Sink Model TBC

TAPWARE
Mixer TBC

OVENS
Generic oven 600 (600 x 600 x 596)
Combi Oven 455mm Model TBC

COOKTOP
Induction cooktop 900 (900 x 520 x 59)

BIN
Nikpol Teramo 74L

Client Approved Signature : ..... Date : .....

Kitchens By Resident Hero
32 Gateway Drive
Phone: 0754471077
mark@residenthero.com.au
www.residenthero.com.au

RHK6581 Lee Smith	**Scale: NTS**	**Sheet 1 of 7**
Kitchen J05 + Butler's J04	Do not scale off this drawing.	Drawn By:
38 Howard St, Grange QLD		Date: 26/10/26


Kitchen J05 + Butler's J04 Plan 1 : 20


SHELVES TO FOLLOW CURVE.

NE CORNER = R500 CURVED WALL
BACK OF SHELF CPBD TRUNCATED
50 SCRIBE FILLER AT FRONT

TOP DRAWER OF THIS DRW STACK IS TO BE A CHARGING DRAW. ALLOW FOR 2 DGPO AT REAR OF DRAWER.

need to run power to island.

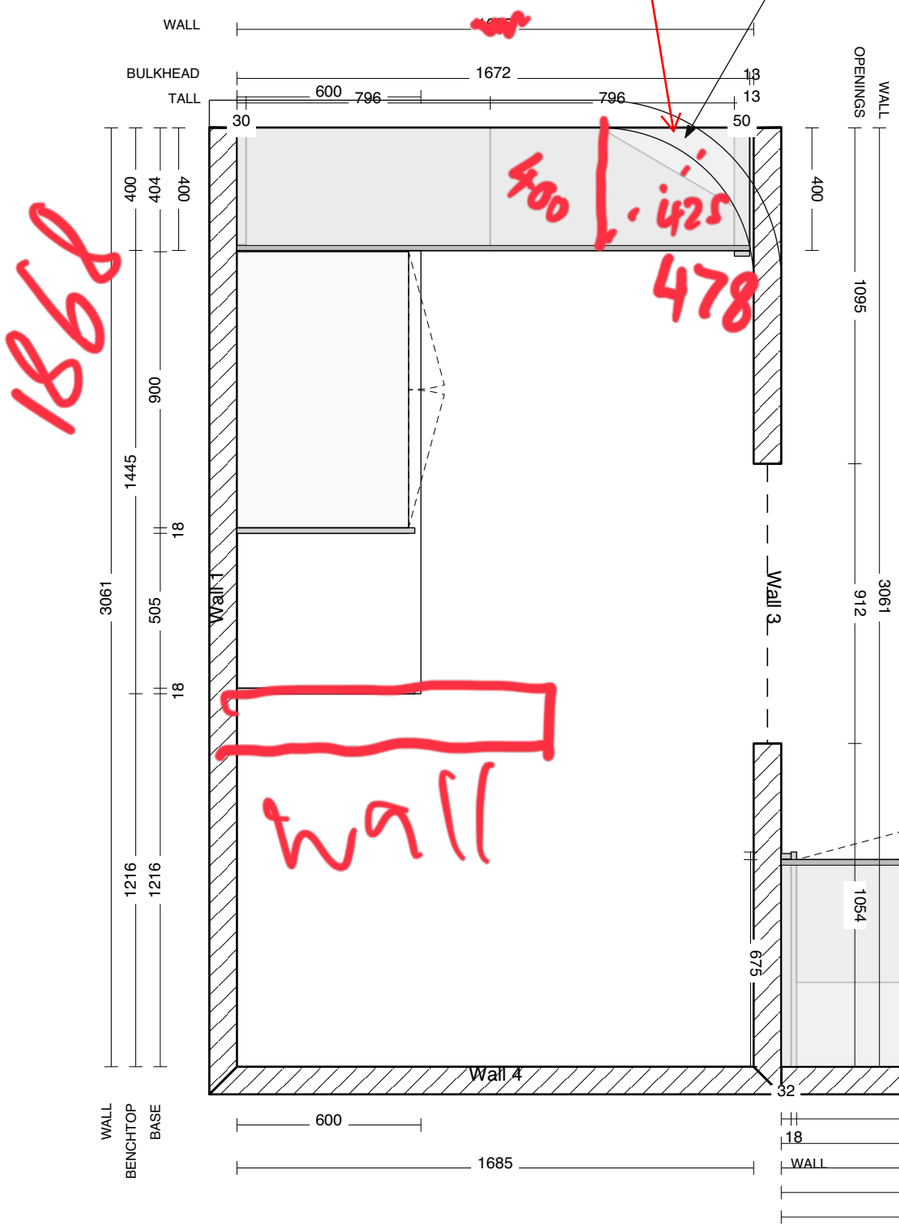

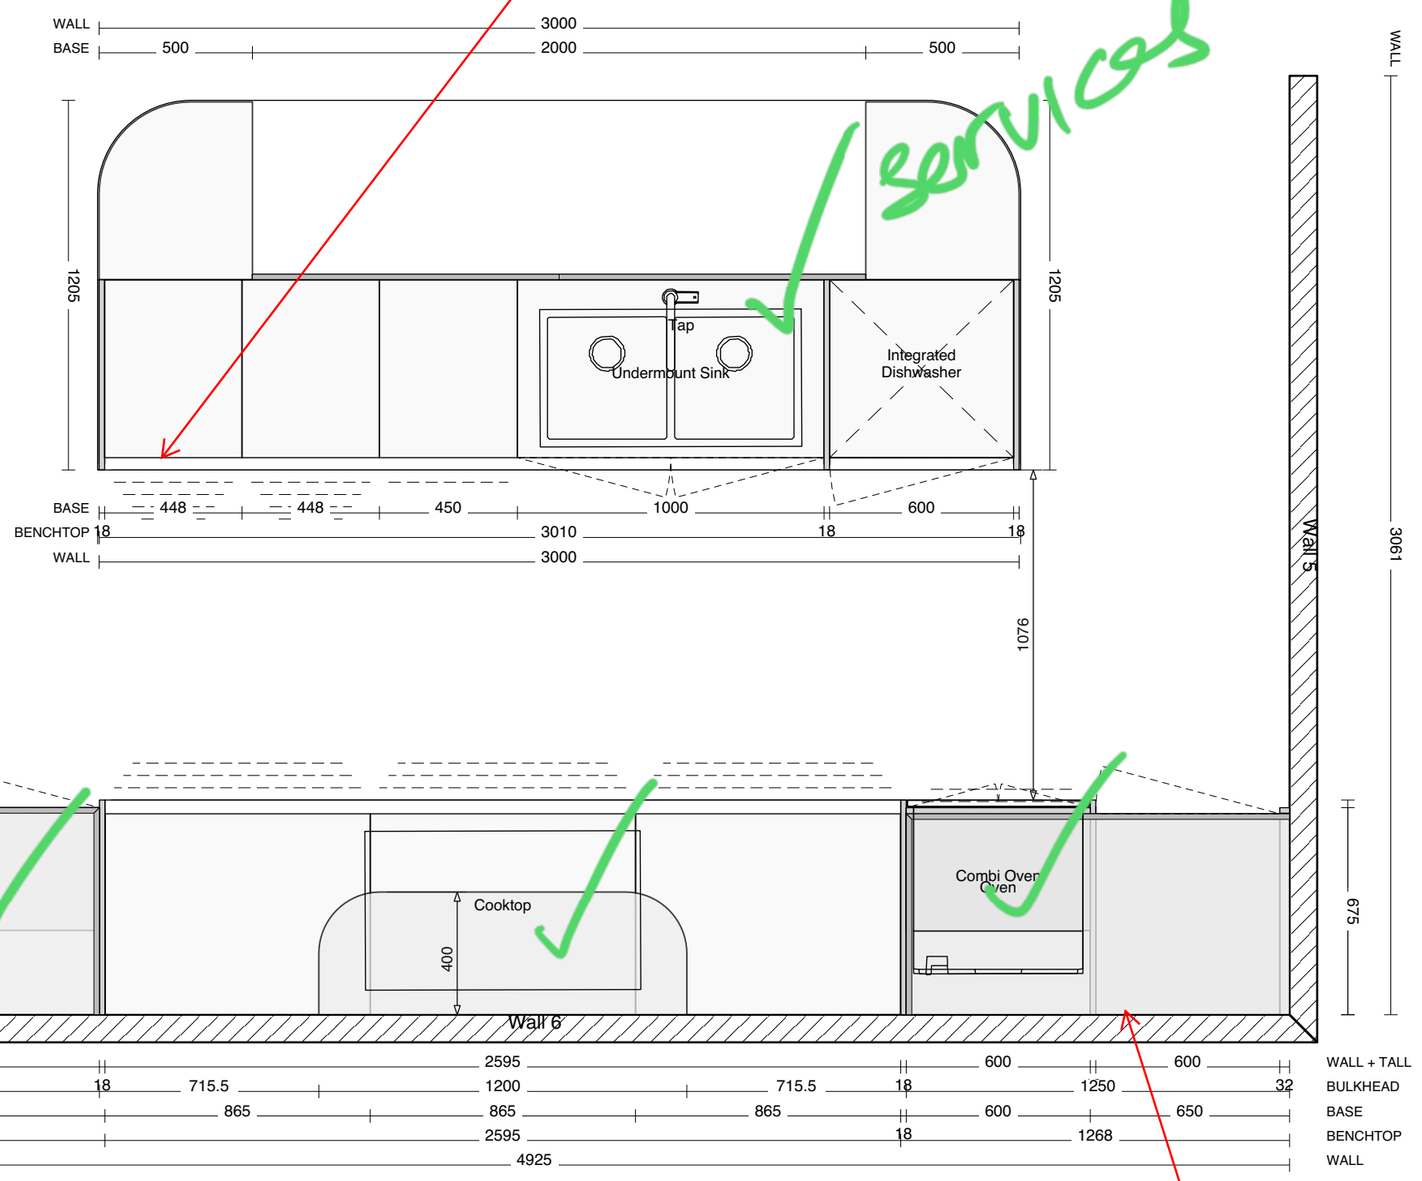


Client Approved Signature : ..... Date : .....

DGPO AT REAR OF CABINET

Kitchens By Resident Hero 32 Gateway Drive Phone: 0754471077 mark@residenthero.com.au www.residenthero.com.au	RHK6581 Lee Smith	**Scale: 1 : 20**	**Sheet 2 of 7**
	Kitchen J05 + Butler's J04	Do not scale off this drawing.	
	38 Howard St, Grange QLD		

Kitchen J05 + Butler's J04 Elevation Wall 1

1 : 20

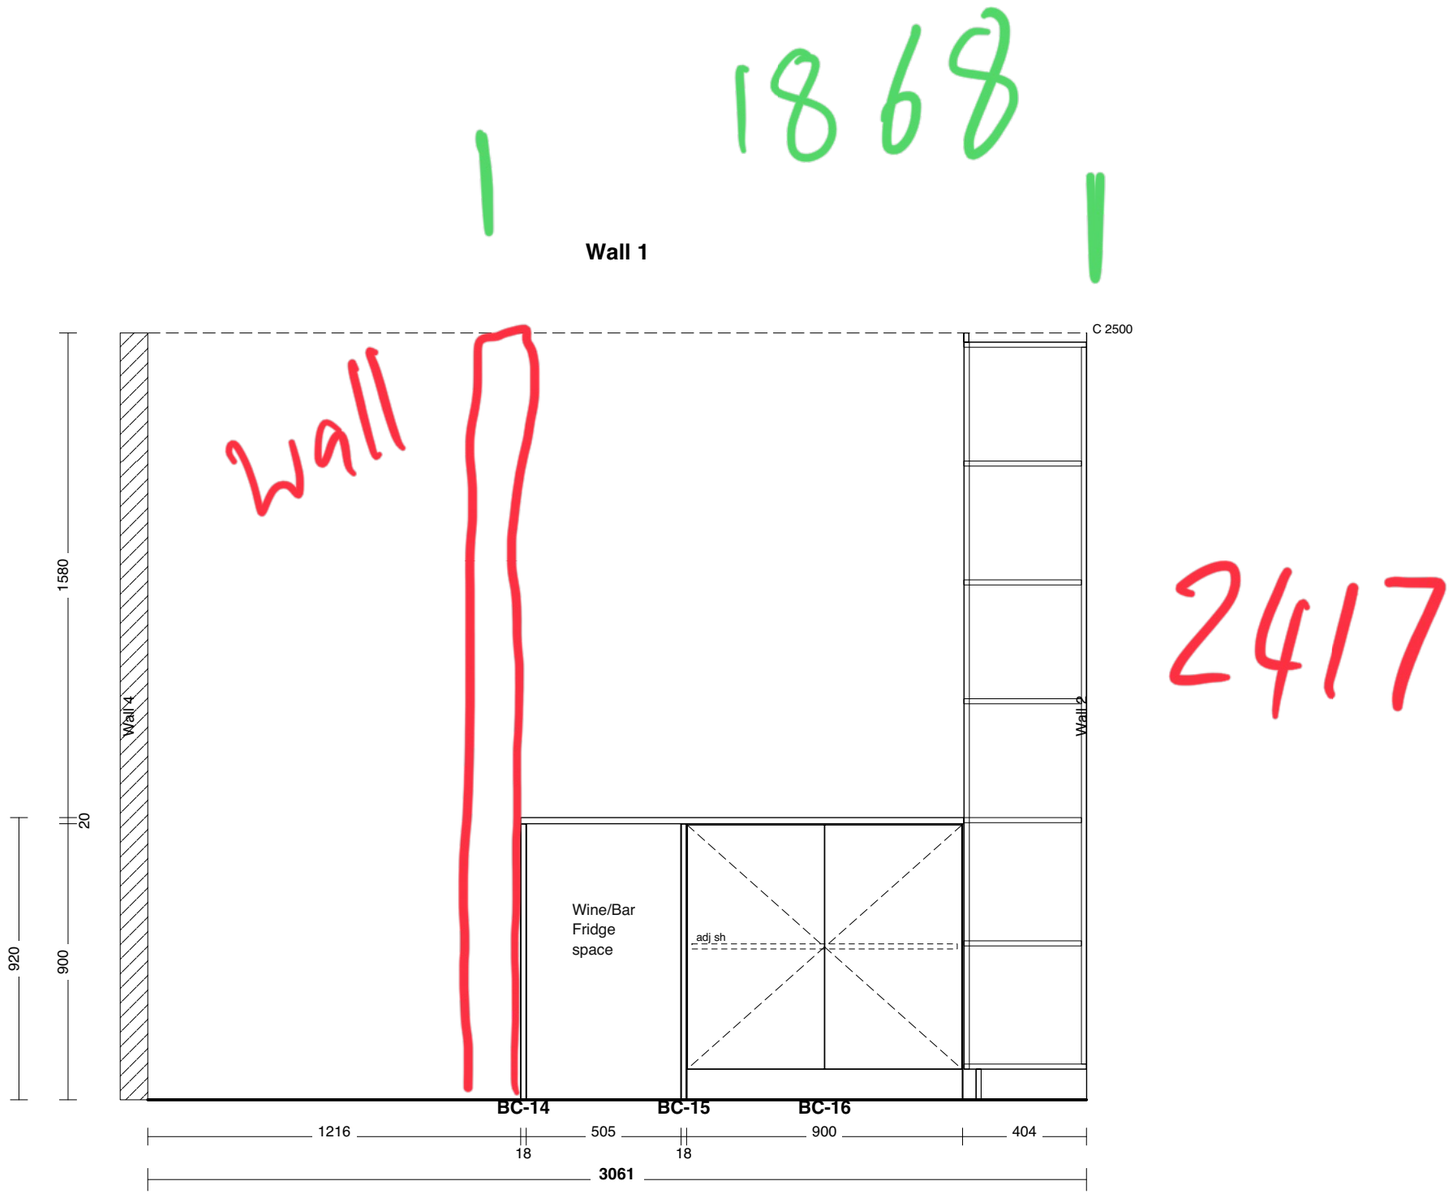

This shop drawing has been examined for compliance with architectural design intent only and does not relieve either builder or subcontractor(s) from their obligations under the Contract, nor shall be deemed to be authorisation for any variation.

- [ ] a. Reviewed, no comments
- [x] b. Reviewed, revise as noted
- [ ] c. Reviewed, revise and resubmit
- [ ] d. Not reviewed

katherine blackham — signed


29/10/2026 — date

Client Approved Signature : ..... Date : .....

Kitchens By Resident Hero 32 Gateway Drive Phone: 0754471077 mark@residenthero.com.au www.residenthero.com.au	RHK6581 Lee Smith	**Scale: 1 : 20**	**Sheet 3 of 7**
	Kitchen J05 + Butler's J04	Do not scale off this drawing.	Drawn By:
	38 Howard St, Grange QLD		Date: 26/10/26

Kitchen J05 + Butler's J04 Elevation Wall 2

1 : 20

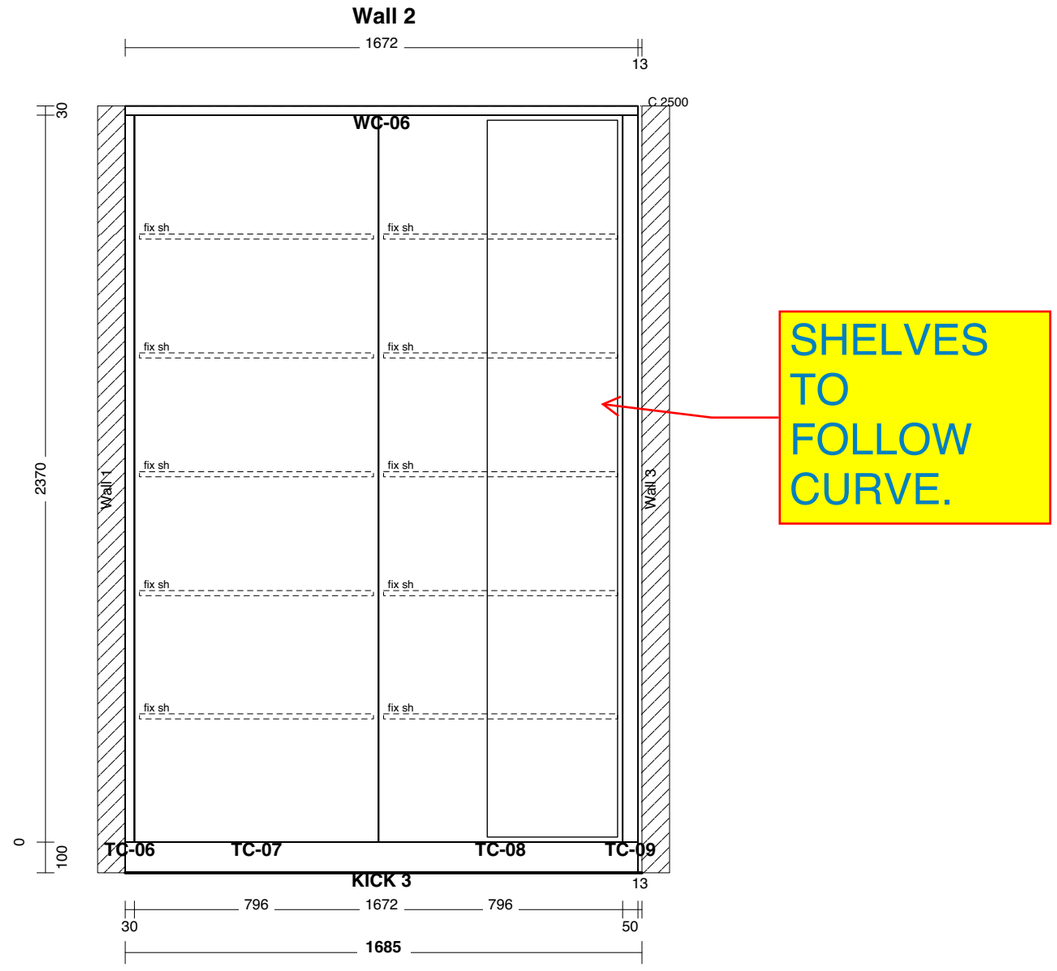

This shop drawing has been examined for compliance with architectural design intent only and does not relieve either builder or subcontractor(s) from their obligations under the Contract, nor shall be deemed to be authorisation for any variation.

- [ ] a. Reviewed, no comments
- [x] b. Reviewed, revise as noted
- [ ] c. Reviewed, revise and resubmit
- [ ] d. Not reviewed


katherine blackham — signed

29/10/2026 — date

Client Approved Signature : ..... Date : .....

Kitchens By Resident Hero 32 Gateway Drive Phone: 0754471077 mark@residenthero.com.au www.residenthero.com.au	RHK6581 Lee Smith	**Scale: 1 : 20**	**Sheet 4 of 7**
	Kitchen J05 + Butler's J04	Do not scale off this drawing.	Drawn By:
	38 Howard St, Grange QLD		Date: 26/10/26

Kitchen J05 + Butler's J04 Elevation Wall 6 1 : 20

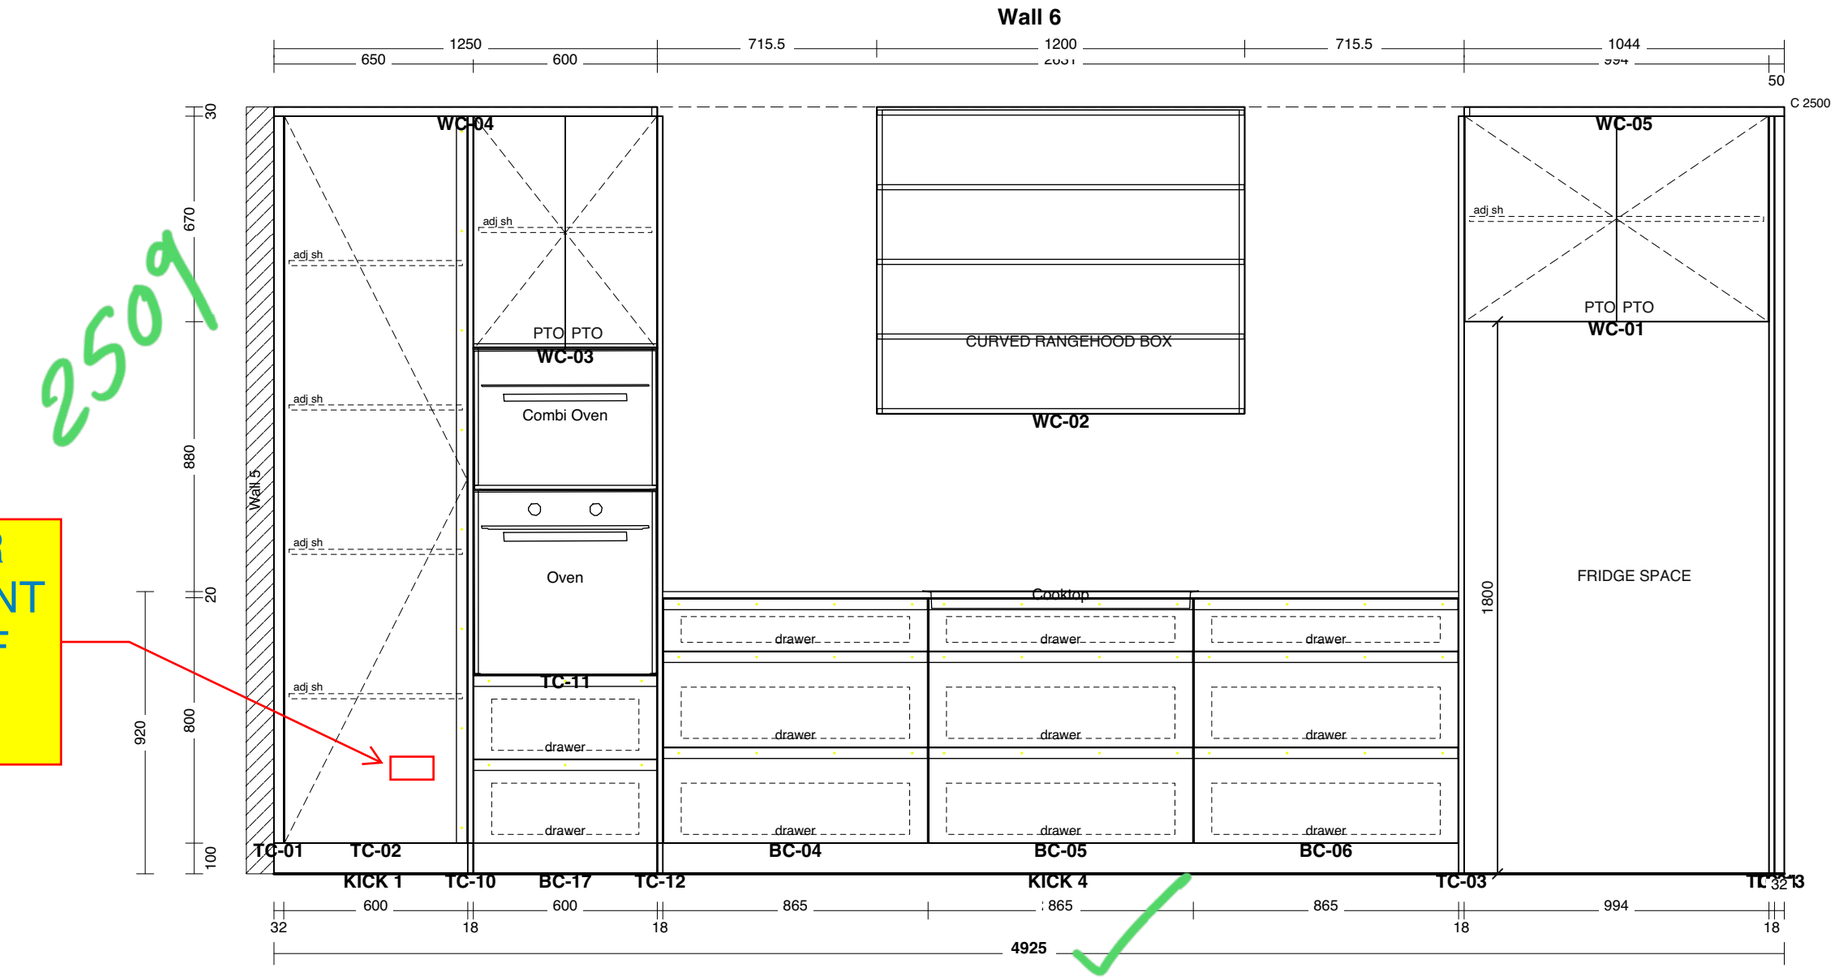

ALLOW FOR POWERPOINT AT REAR OF CABINET

This shop drawing has been examined for compliance with architectural design intent only and does not relieve either builder or subcontractor(s) from their obligations under the Contract, nor shall be deemed to be authorisation for any variation.

- [ ] a. Reviewed, no comments
- [x] b. Reviewed, revise as noted
- [ ] c. Reviewed, revise and resubmit
- [ ] d. Not reviewed

katherine blackham — signed


29/10/2026 — date

Client Approved Signature : ..... Date : .....

Kitchens By Resident Hero 32 Gateway Drive Phone: 0754471077 mark@residenthero.com.au www.residenthero.com.au	RHK6581 Lee Smith	**Scale: 1 : 20**	**Sheet 5 of 7**
	Kitchen J05 + Butler's J04	Do not scale off this drawing.	Drawn By:
	38 Howard St, Grange QLD		Date: 26/10/26

Kitchen J05 + Butler's J04 Elevation Wall 7 1 : 20

TOP DRAWER OF THIS DRW STACK IS TO BE A CHARGING DRAW. ALLOW FOR 2 DGPO AT REAR OF DRAWER.

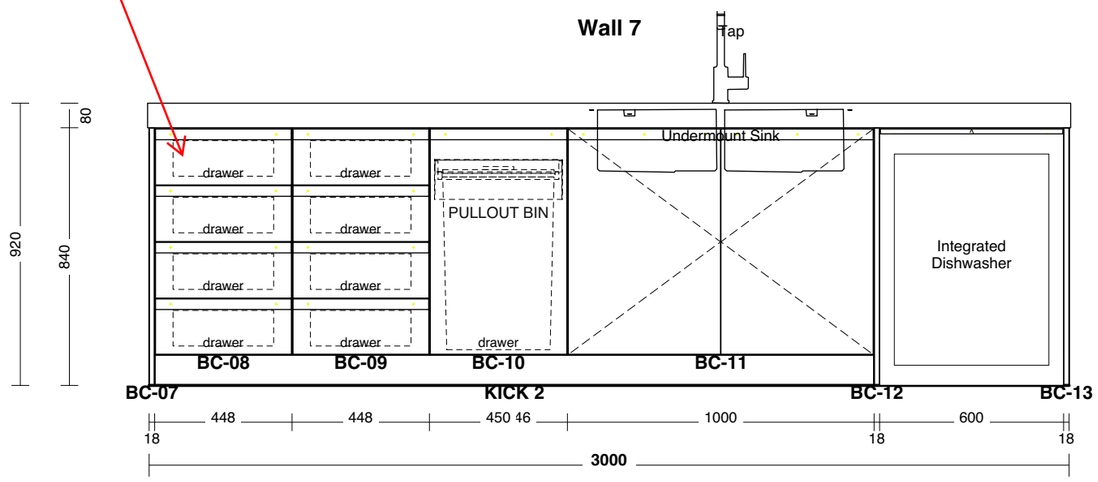

This shop drawing has been examined for compliance with architectural design intent only and does not relieve either builder or subcontractor(s) from their obligations under the Contract, nor shall be deemed to be authorisation for any variation.

- [ ] a. Reviewed, no comments
- [x] b. Reviewed, revise as noted
- [ ] c. Reviewed, revise and resubmit
- [ ] d. Not reviewed

katherine blackham — signed


29/10/2026 — date

Client Approved Signature : ..... Date : .....

Kitchens By Resident Hero 32 Gateway Drive Phone: 0754471077 mark@residenthero.com.au www.residenthero.com.au	RHK6581 Lee Smith	**Scale: 1 : 20**	**Sheet 6 of 7**
	Kitchen J05 + Butler's J04	Do not scale off this drawing.	Drawn By:
	38 Howard St, Grange QLD		Date: 26/10/26

Kitchen J05 + Butler's J04 Elevation Wall 7 — back 1 : 20

Wall 7 — back

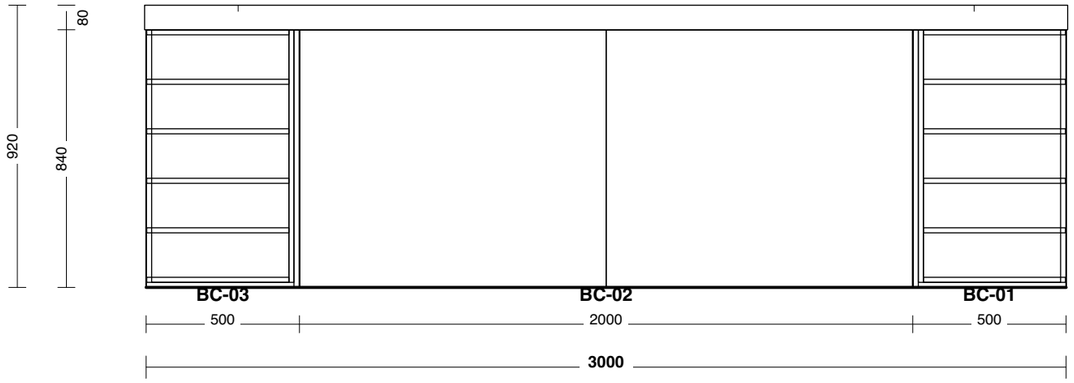

This shop drawing has been examined for compliance with architectural design intent only and does not relieve either builder or subcontractor(s) from their obligations under the Contract, nor shall be deemed to be authorisation for any variation.

- [ ] a. Reviewed, no comments
- [x] b. Reviewed, revise as noted
- [ ] c. Reviewed, revise and resubmit
- [ ] d. Not reviewed

katherine blackham — signed

29/10/2026 — date

Client Approved Signature : ..... Date : .....

Kitchens By Resident Hero 32 Gateway Drive Phone: 0754471077 mark@residenthero.com.au www.residenthero.com.au	RHK6581 Lee Smith	**Scale: 1 : 20**	**Sheet 7 of 7**
	Kitchen J05 + Butler's J04	Do not scale off this drawing.	Drawn By:
	38 Howard St, Grange QLD		Date: 26/10/26