
Living J06 Plan 1 : 20

Wall is out of Plumb

Allow 12m tag.

2570

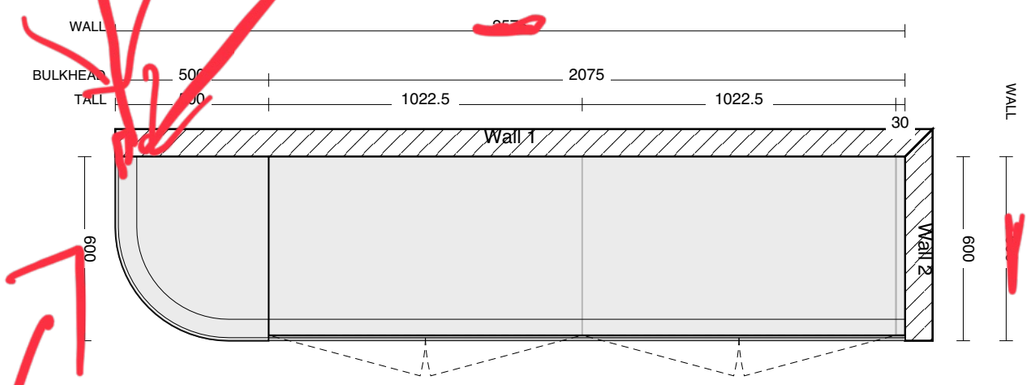

This shop drawing has been examined for compliance with architectural design intent only and does not relieve either builder or subcontractor(s) from their obligations under the Contract, nor shall be deemed to be authorisation for any variation.

- ☐ a. Reviewed, no comments
- ☒ b. Reviewed, revise as noted
- ☐ c. Reviewed, revise and resubmit
- ☐ d. Not reviewed

katherine blackham — signed

29/10/2026 — date

SPECIFICATIONS - Living J06
RHK6581 Lee Smith

FRONTS + PANELS
Laminex 16mm ~~- Aries OR Surf (colour TBC)~~
Panels: -

laminex desert dune
natural finish
2595

HANDLES
Client supplied - undrilled

CARCASS
Whiteboard 16.5mm

HARDWARE
Hinges: Blum

595

Will have slight overk.

Client Approved Signature : ..... Date : .....

Kitchens By Resident Hero 32 Gateway Drive Phone: 0754471077 mark@residenthero.com.au www.residenthero.com.au	RHK6581 Lee Smith	**Scale: 1 : 20**	**Sheet 1 of 3**
	Living J06	Do not scale off this drawing.	Drawn By:
	38 Howard St, Grange QLD		Date: 26/10/26

Living J06 Elevation Wall 1


1 : 20

This shop drawing has been examined for compliance with architectural design intent only and does not relieve either builder or subcontractor(s) from their obligations under the Contract, nor shall be deemed to be authorisation for any variation.

- [ ] a. Reviewed, no comments
- [x] b. Reviewed, revise as noted
- [ ] c. Reviewed, revise and resubmit
- [ ] d. Not reviewed

katherine blackham — signed

29/10/2026 — date

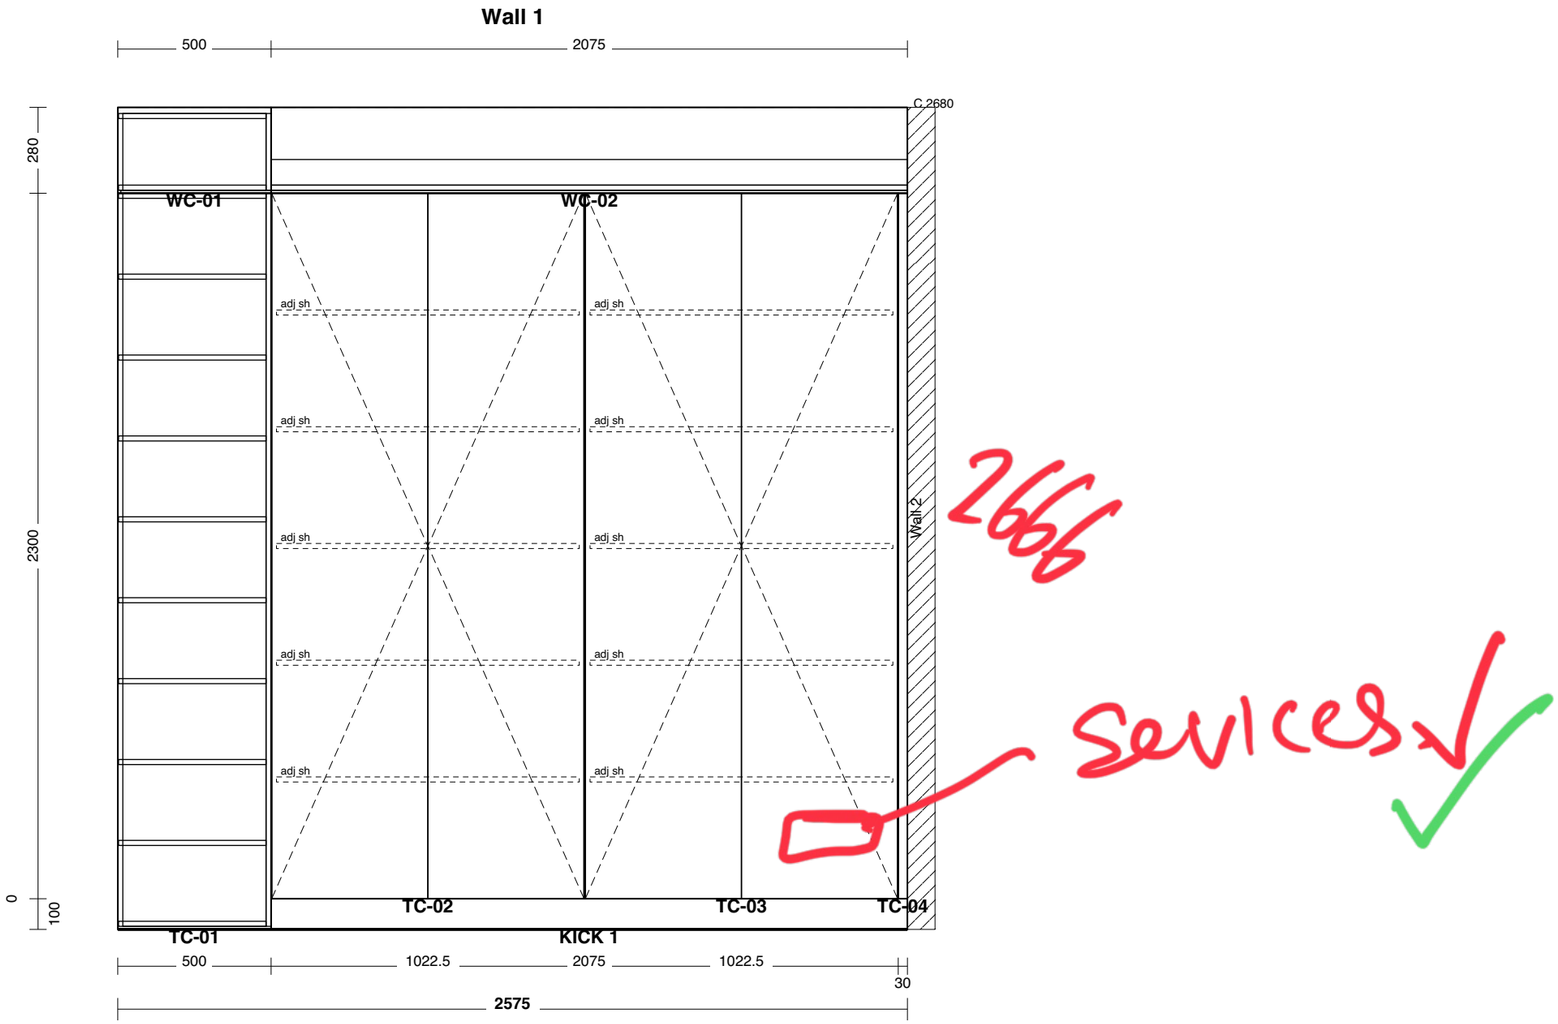


2666

services ✓

Client Approved Signature : ..... Date : .....

Kitchens By Resident Hero 32 Gateway Drive Phone: 0754471077 mark@residenthero.com.au www.residenthero.com.au	RHK6581 Lee Smith	**Scale: 1 : 20**	**Sheet 2 of 3**
	Living J06	Do not scale off this drawing.	Drawn By:
	38 Howard St, Grange QLD		Date: 26/10/26

Living J06 3D NTS

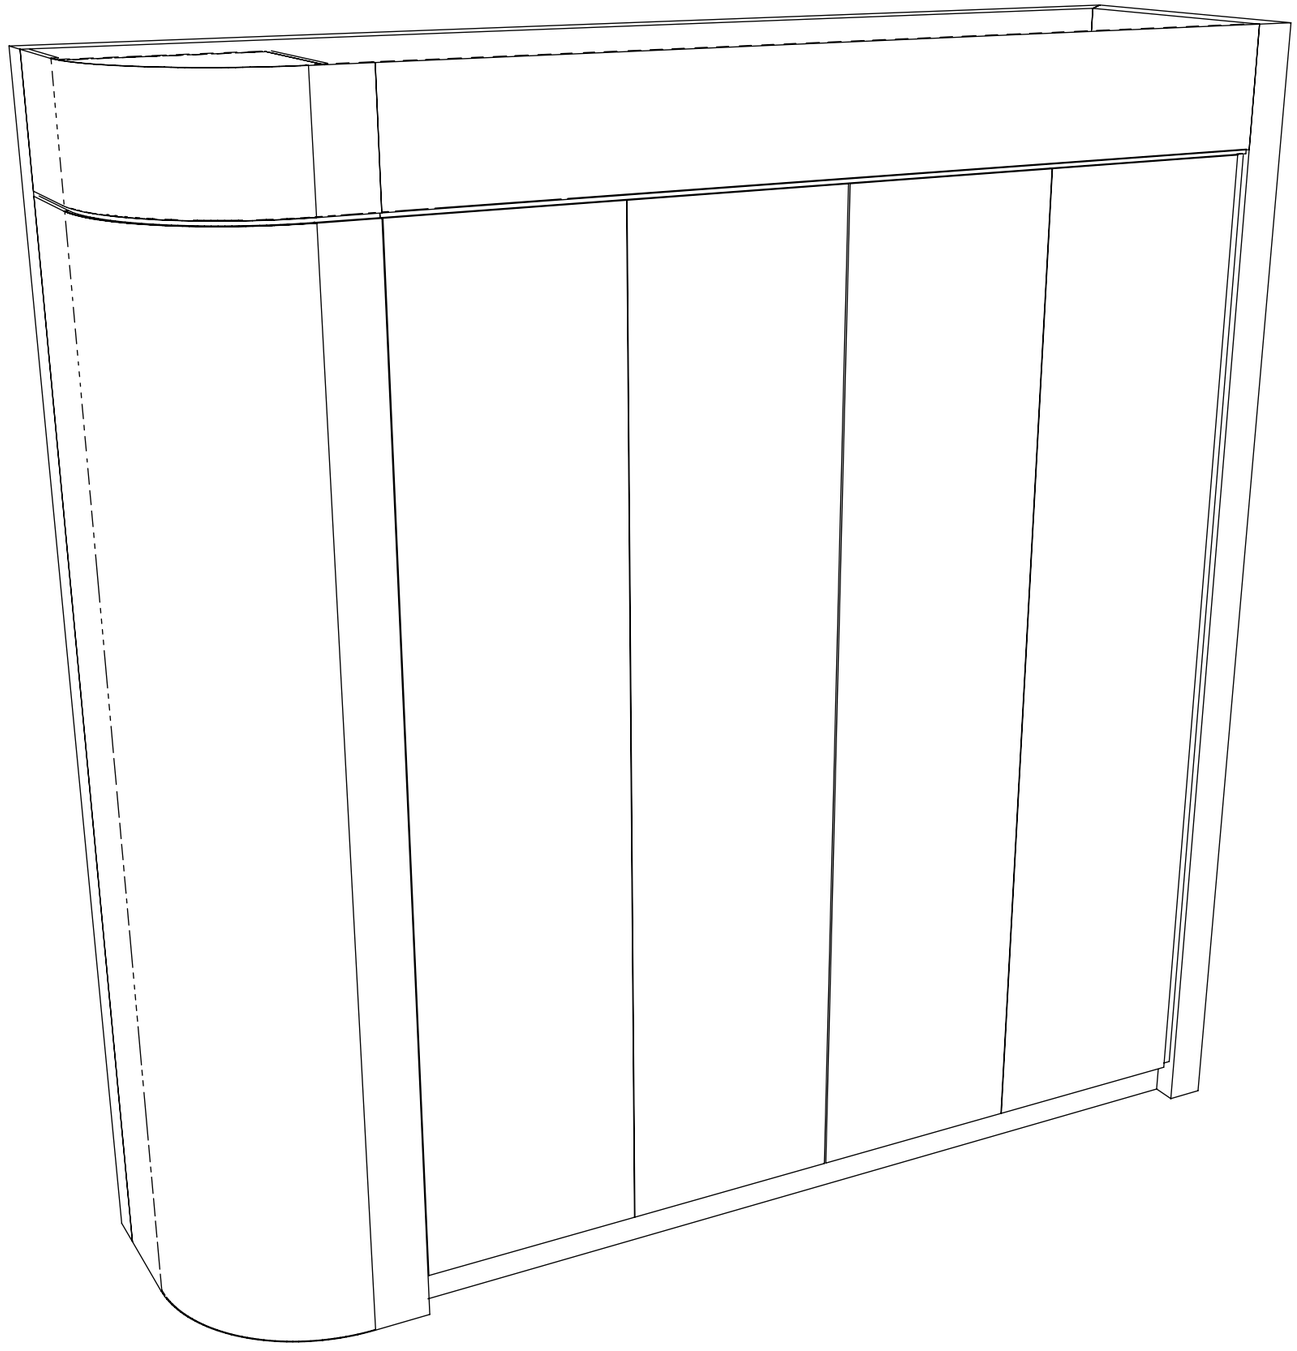

This shop drawing has been examined for compliance with architectural design intent only and does not relieve either builder or subcontractor(s) from their obligations under the Contract, nor shall be deemed to be authorisation for any variation.

- [ ] a. Reviewed, no comments
- [x] b. Reviewed, revise as noted
- [ ] c. Reviewed, revise and resubmit
- [ ] d. Not reviewed

katherine blackham — signed

29/10/2026 — date

Client Approved Signature : ..... Date : .....

Kitchens By Resident Hero 32 Gateway Drive Phone: 0754471077 mark@residenthero.com.au www.residenthero.com.au	RHK6581 Lee Smith	**Scale: NTS**	**Sheet 3 of 3**
	Living J06	Do not scale off this drawing.	Drawn By:
	38 Howard St, Grange QLD		Date: 26/10/26