Master Store J12 Plan

1 : 20

This shop drawing has been examined for compliance with architectural design intent only and does not relieve either builder or subcontractor(s) from their obligations under the Contract, nor shall be deemed to be authorisation for any variation.


- [ ] a. Reviewed, no comments
- [x] b. Reviewed, revise as noted
- [ ] c. Reviewed, revise and resubmit
- [ ] d. Not reviewed

katherine blackham

signed

29/10/2026

date

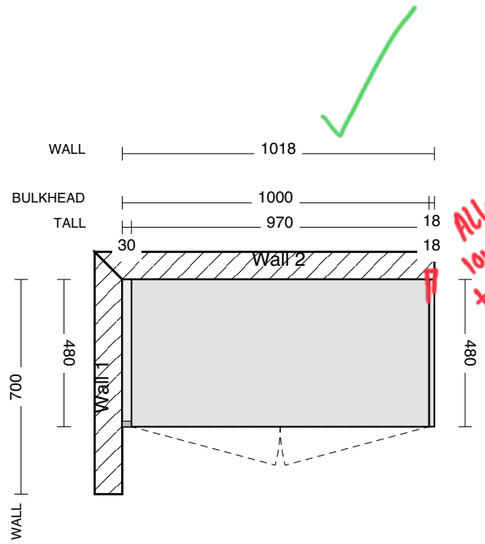

Allow 10mm tag for scribe

SPECIFICATIONS - Master Store J12
RHK6581 Lee Smith

FRONTS + PANELS
Laminex 18mm ABS Grain - Elegant Oak
Panels:

HANDLES
Client supplied - undrilled

CARCASS
Whiteboard 16.5mm

HARDWARE
Hinges: Blum

Client Approved Signature : ..... Date : .....

Kitchens By Resident Hero 32 Gateway Drive Phone: 0754471077 mark@residenthero.com.au www.residenthero.com.au	RHK6581 Lee Smith	**Scale: 1 : 20**	**Sheet 1 of 3**
	Master Store J12	Do not scale off this drawing.	Drawn By:
	38 Howard St, Grange QLD		Date: 26/10/26


Master Store J12 Elevation Wall 2 1 : 20

This shop drawing has been examined for compliance with architectural design intent only and does not relieve either builder or subcontractor(s) from their obligations under the Contract, nor shall be deemed to be authorisation for any variation.

- ☐ a. Reviewed, no comments
- ☒ b. Reviewed, revise as noted
- ☐ c. Reviewed, revise and resubmit
- ☐ d. Not reviewed

katherine blackham — signed


29/10/2026 — date

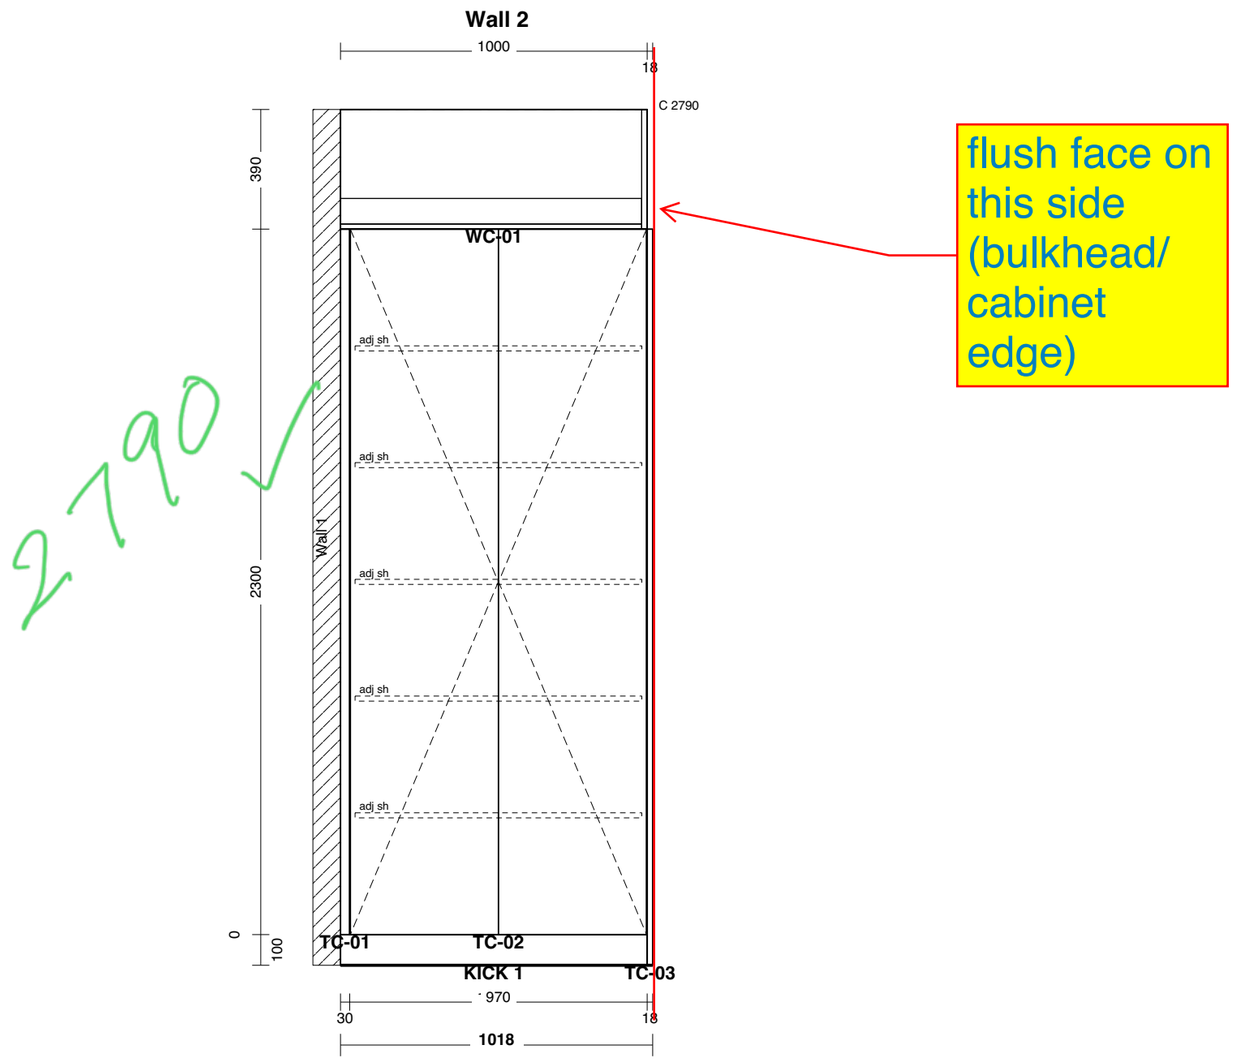

Client Approved Signature : ..... Date : .....

Kitchens By Resident Hero 32 Gateway Drive Phone: 0754471077 mark@residenthero.com.au www.residenthero.com.au	RHK6581 Lee Smith	**Scale: 1 : 20**	**Sheet 2 of 3**
	Master Store J12	Do not scale off this drawing.	Drawn By:
	38 Howard St, Grange QLD		Date: 26/10/26

Master Store J12 3D NTS

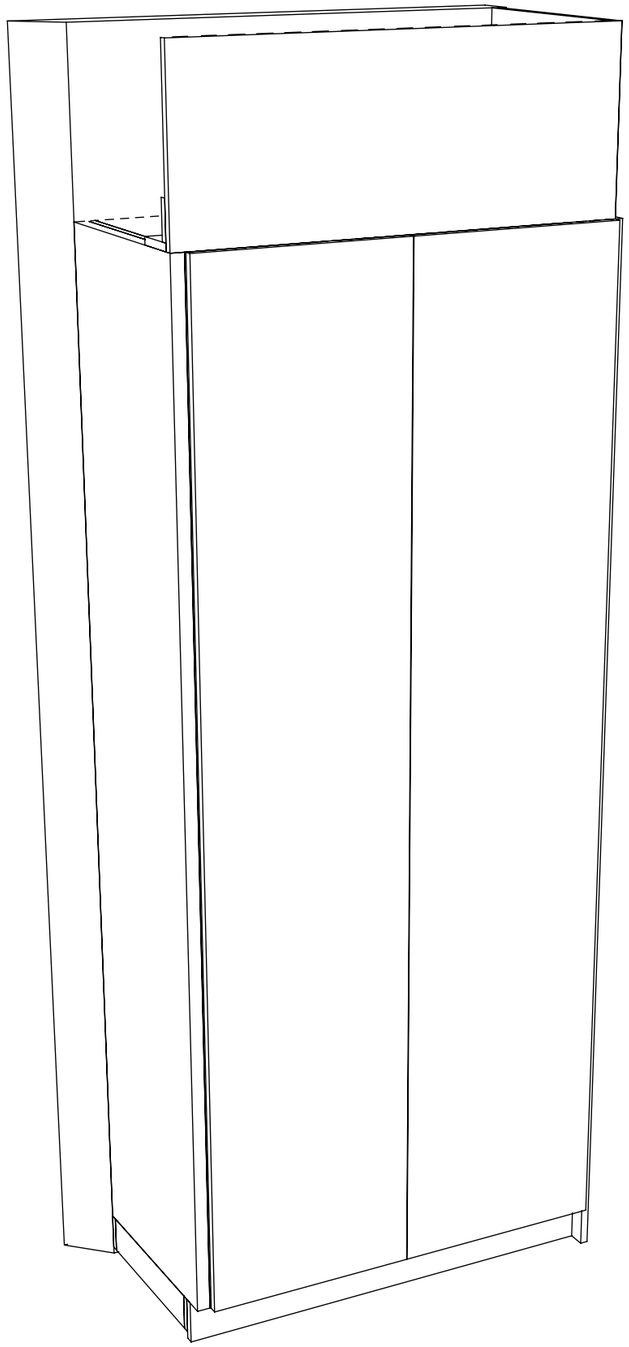

This shop drawing has been examined for compliance with architectural design intent only and does not relieve either builder or subcontractor(s) from their obligations under the Contract, nor shall be deemed to be authorisation for any variation.

- [ ] a. Reviewed, no comments
- [x] b. Reviewed, revise as noted
- [ ] c. Reviewed, revise and resubmit
- [ ] d. Not reviewed

katherine blackham
signed

29/10/2026
date

Client Approved Signature : ..... Date : .....

Kitchens By Resident Hero 32 Gateway Drive Phone: 0754471077 mark@residenthero.com.au www.residenthero.com.au	RHK6581 Lee Smith	**Scale: NTS**	**Sheet 3 of 3**
	Master Store J12	Do not scale off this drawing.	Drawn By:
	38 Howard St, Grange QLD		Date: 26/10/26