
Play J07M Plan 1 : 20

notes as per j07

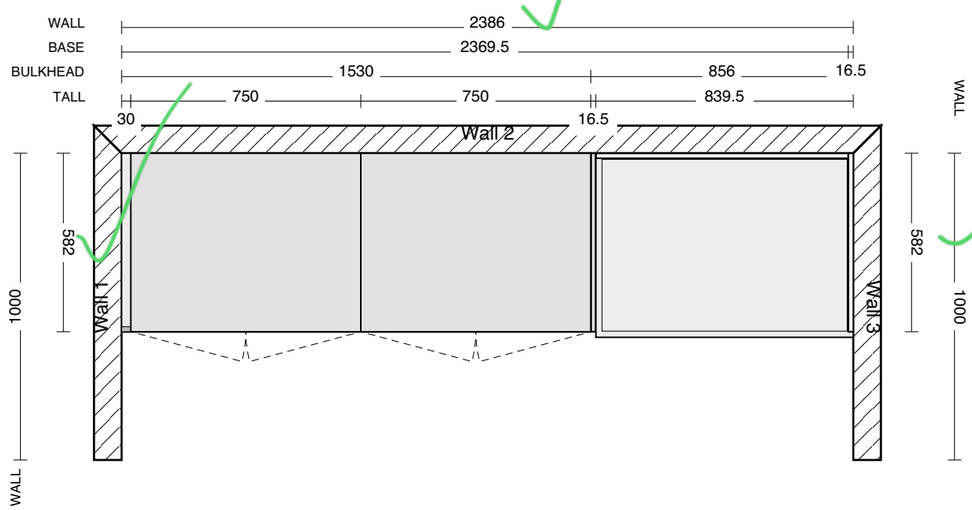

SPECIFICATIONS - Play J07M
RHK6581 Lee Smith

FRONTS + PANELS
Laminex 16mm Colour - Sunbaked Natural
Panels: -

HANDLES
Client supplied - undrilled

CARCASS
Whiteboard 16.5mm

HARDWARE
Hinges: Blum

This shop drawing has been examined for compliance with architectural design intent only and does not relieve either builder or subcontractor(s) from their obligations under the Contract, nor shall be deemed to be authorisation for any variation.

- ☐ a. Reviewed, no comments
- ☒ b. Reviewed, revise as noted
- ☐ c. Reviewed, revise and resubmit
- ☐ d. Not reviewed

katherine blackham — signed

29/10/2026 — date


Client Approved Signature : ..... Date : .....

Kitchens By Resident Hero 32 Gateway Drive Phone: 0754471077 mark@residenthero.com.au www.residenthero.com.au	RHK6581 Lee Smith	**Scale: 1 : 20**	**Sheet 1 of 3**
	Play J07M	Do not scale off this drawing.	Drawn By:
	38 Howard St, Grange QLD		Date: 26/10/26

Play J07M Elevation Wall 2 1 : 20

notes as per j07

flush finish to end panel/ bulkhead on side

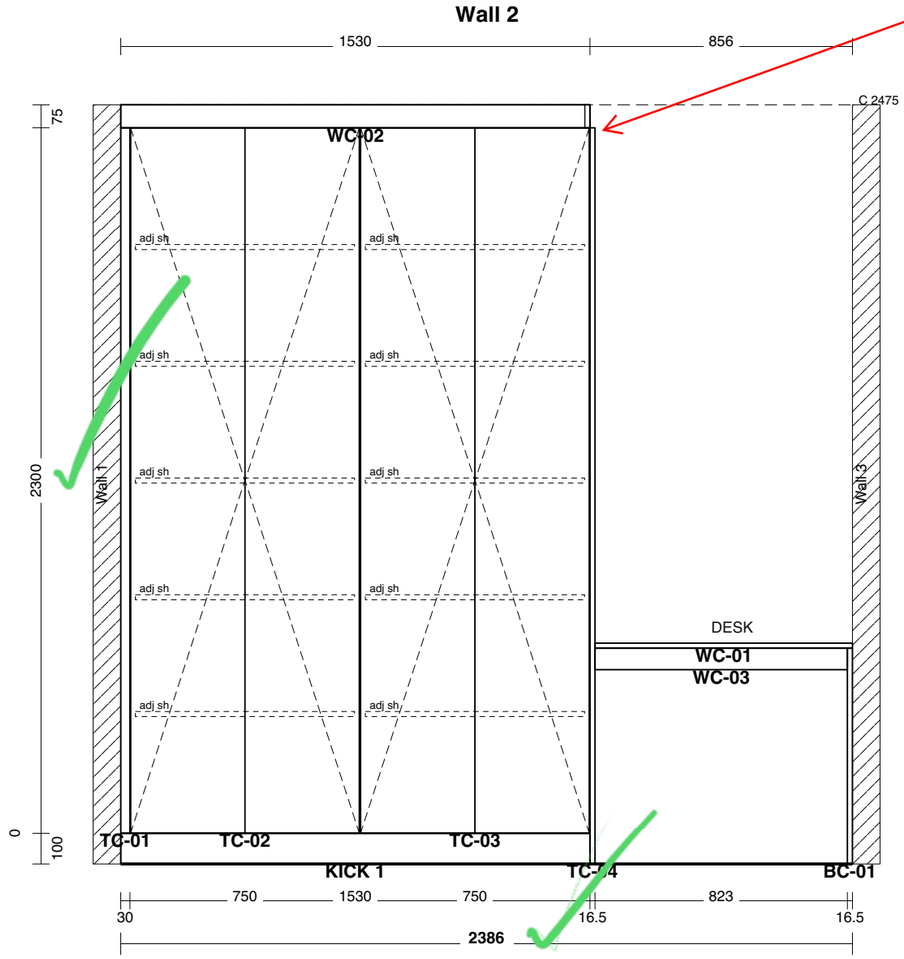

This shop drawing has been examined for compliance with architectural design intent only and does not relieve either builder or subcontractor(s) from their obligations under the Contract, nor shall be deemed to be authorisation for any variation.

- [ ] a. Reviewed, no comments
- [x] b. Reviewed, revise as noted
- [ ] c. Reviewed, revise and resubmit
- [ ] d. Not reviewed


katherine blackham — signed

29/10/2026 — date

Client Approved Signature : ..... Date : .....

Kitchens By Resident Hero 32 Gateway Drive Phone: 0754471077 mark@residenthero.com.au www.residenthero.com.au	RHK6581 Lee Smith	**Scale: 1 : 20**	**Sheet 2 of 3**
	Play J07M	Do not scale off this drawing.	Drawn By:
	38 Howard St, Grange QLD		Date: 26/10/26

Play J07M 3D NTS

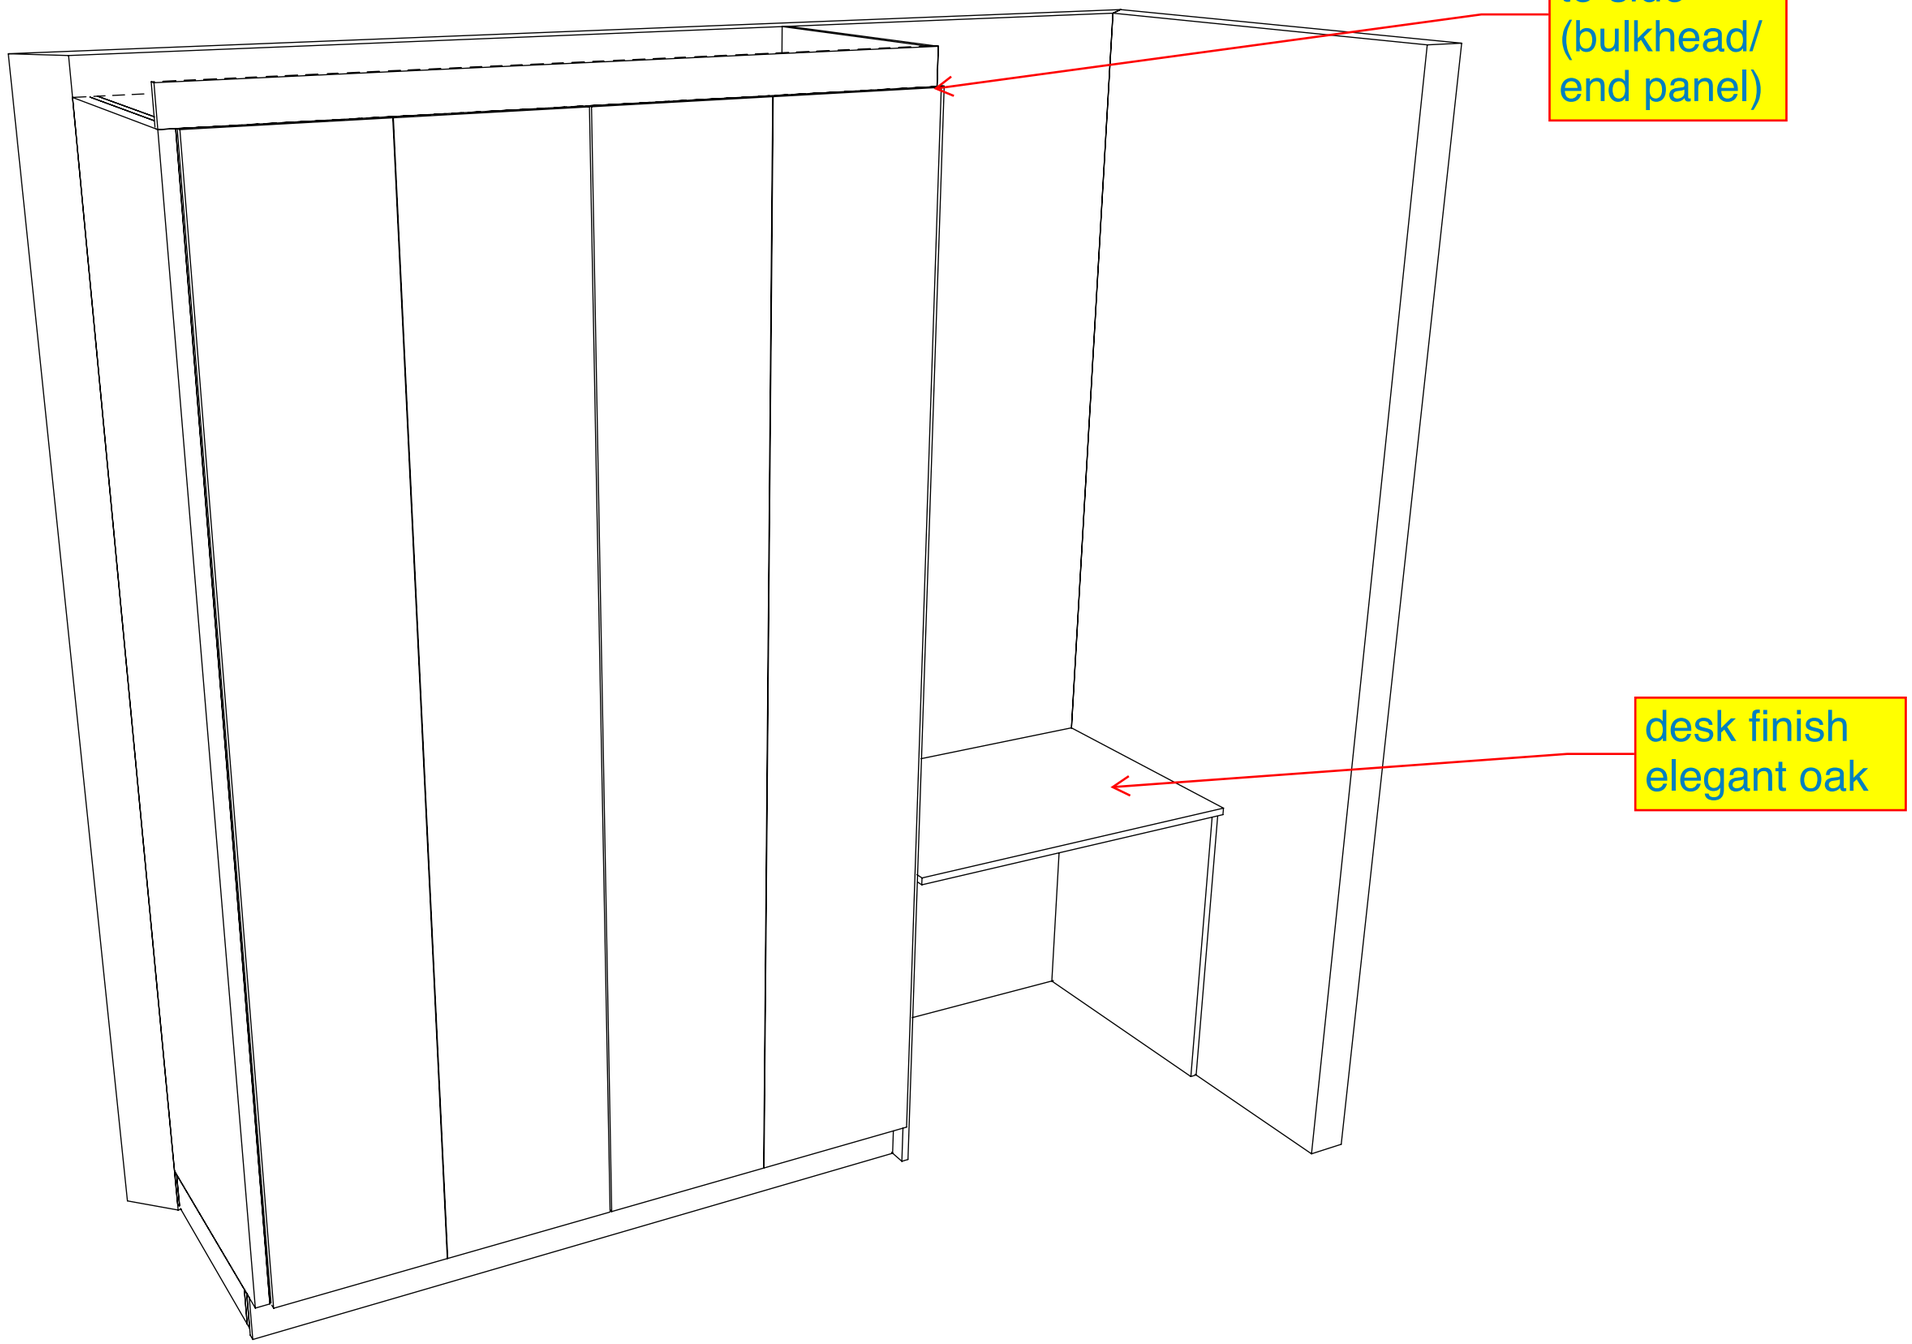

This shop drawing has been examined for compliance with architectural design intent only and does not relieve either builder or subcontractor(s) from their obligations under the Contract, nor shall be deemed to be authorisation for any variation.

- [ ] a. Reviewed, no comments
- [x] b. Reviewed, revise as noted
- [ ] c. Reviewed, revise and resubmit
- [ ] d. Not reviewed

katherine blackham — signed

29/10/2026 — date

Client Approved Signature : ..... Date : .....

Kitchens By Resident Hero 32 Gateway Drive Phone: 0754471077 mark@residenthero.com.au www.residenthero.com.au	RHK6581 Lee Smith	**Scale: NTS**	**Sheet 3 of 3**
	Play J07M	Do not scale off this drawing.	Drawn By:
	38 Howard St, Grange QLD		Date: 26/10/26