
Storage J10 Plan 1 : 20

This shop drawing has been examined for compliance with architectural design intent only and does not relieve either builder or subcontractor(s) from their obligations under the Contract, nor shall be deemed to be authorisation for any variation.

- [ ] a. Reviewed, no comments
- [x] b. Reviewed, revise as noted
- [ ] c. Reviewed, revise and resubmit
- [ ] d. Not reviewed

katherine blackham — signed

29/10/2026 — date

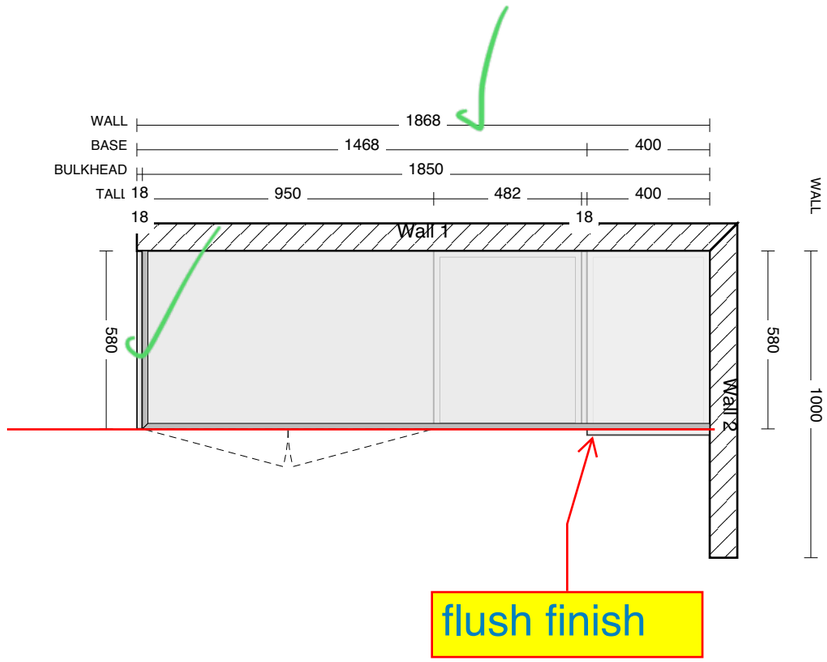

SPECIFICATIONS - Storage J10
RHK6581 Lee Smith

FRONTS + PANELS
Laminex 18mm ABS Grain - Elegant Oak
Panels: -

HANDLES
Client supplied - undrilled

CARCASS
Whiteboard 16.5mm


HARDWARE
Hinges: Blum

Client Approved Signature : ..... Date : .....

Kitchens By Resident Hero 32 Gateway Drive Phone: 0754471077 mark@residenthero.com.au www.residenthero.com.au	RHK6581 Lee Smith	**Scale: 1 : 20**	**Sheet 1 of 3**
	Storage J10	Do not scale off this drawing.	Drawn By:
	38 Howard St, Grange QLD		Date: 26/10/26

Storage J10 Elevation Wall 1 1 : 20

flush finish to visible end of joinery

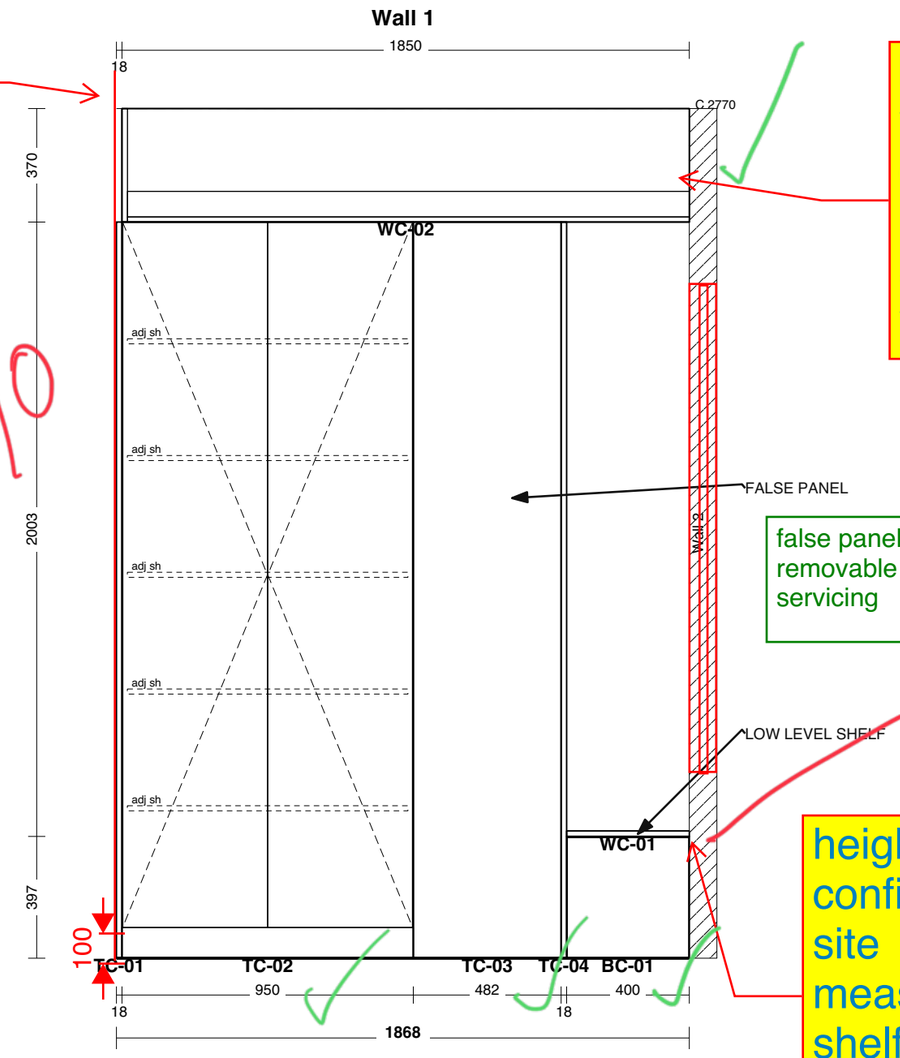

bulkhead to wall will need to be confirmed at site measure. There is a window in this wall

Clears Window

2770

false panel to be removable for servicing

Leave Loose Max Height 440

height to be confirmed at site measure. shelf to sit below window sill

This shop drawing has been examined for compliance with architectural design intent only and does not relieve either builder or subcontractor(s) from their obligations under the Contract, nor shall be deemed to be authorisation for any variation.

- [ ] a. Reviewed, no comments
- [x] b. Reviewed, revise as noted
- [ ] c. Reviewed, revise and resubmit
- [ ] d. Not reviewed


katherine blackham — signed

29/10/2026 — date

Client Approved Signature : ..... Date : .....

Kitchens By Resident Hero 32 Gateway Drive Phone: 0754471077 mark@residenthero.com.au www.residenthero.com.au	RHK6581 Lee Smith	**Scale: 1 : 20**	**Sheet 2 of 3**
	Storage J10	Do not scale off this drawing.	Drawn By:
	38 Howard St, Grange QLD		Date: 26/10/26

Storage J10 3D NTS

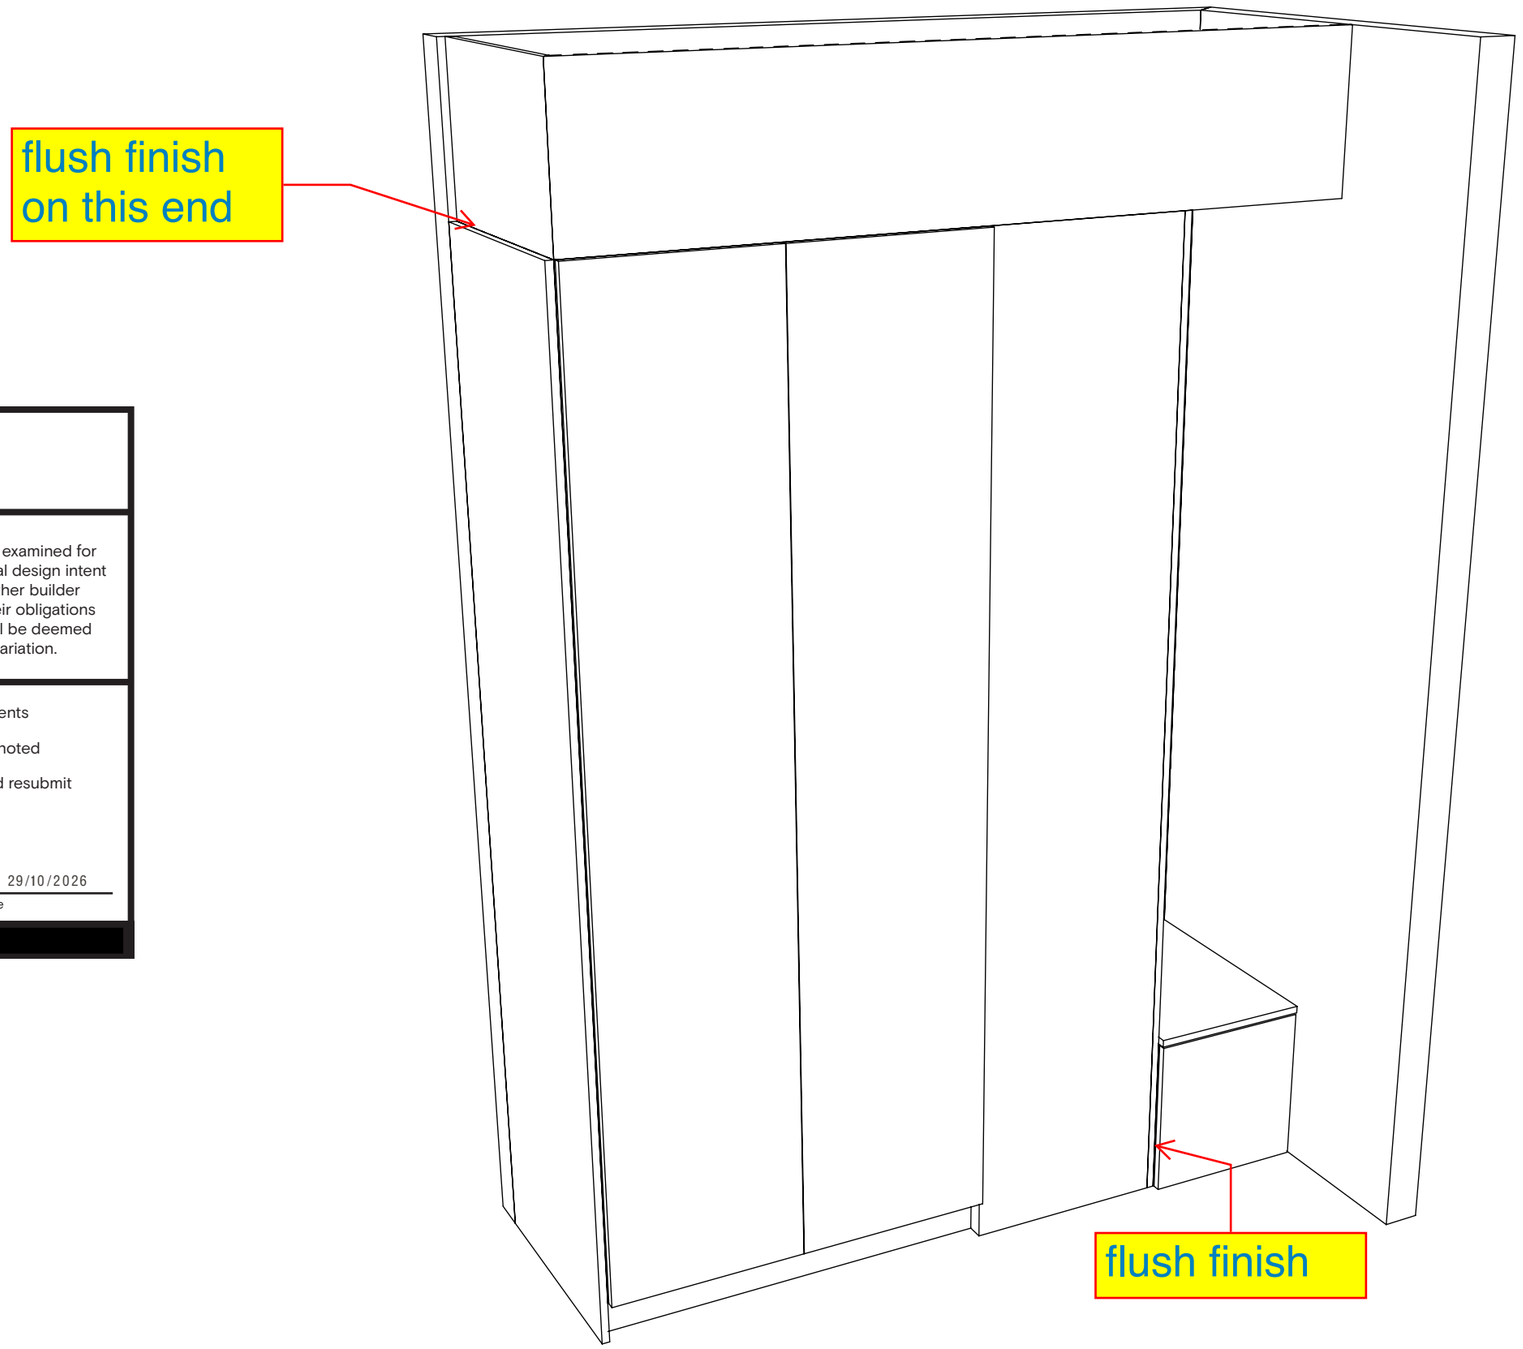

This shop drawing has been examined for compliance with architectural design intent only and does not relieve either builder or subcontractor(s) from their obligations under the Contract, nor shall be deemed to be authorisation for any variation.

- [ ] a. Reviewed, no comments
- [x] b. Reviewed, revise as noted
- [ ] c. Reviewed, revise and resubmit
- [ ] d. Not reviewed

katherine blackham — signed

29/10/2026 — date

Client Approved Signature : ..... Date : .....

Kitchens By Resident Hero 32 Gateway Drive Phone: 0754471077 mark@residenthero.com.au www.residenthero.com.au	RHK6581 Lee Smith	**Scale: NTS**	**Sheet 3 of 3**
	Storage J10	Do not scale off this drawing.	Drawn By:
	38 Howard St, Grange QLD		Date: 26/10/26